


T. 2N. R. 27E.W.M. Sec. 1, 2, 11, 12

Mapped by W. E. O. Criger.

Scale 4 inches = 1 Mile

Feb. 1952

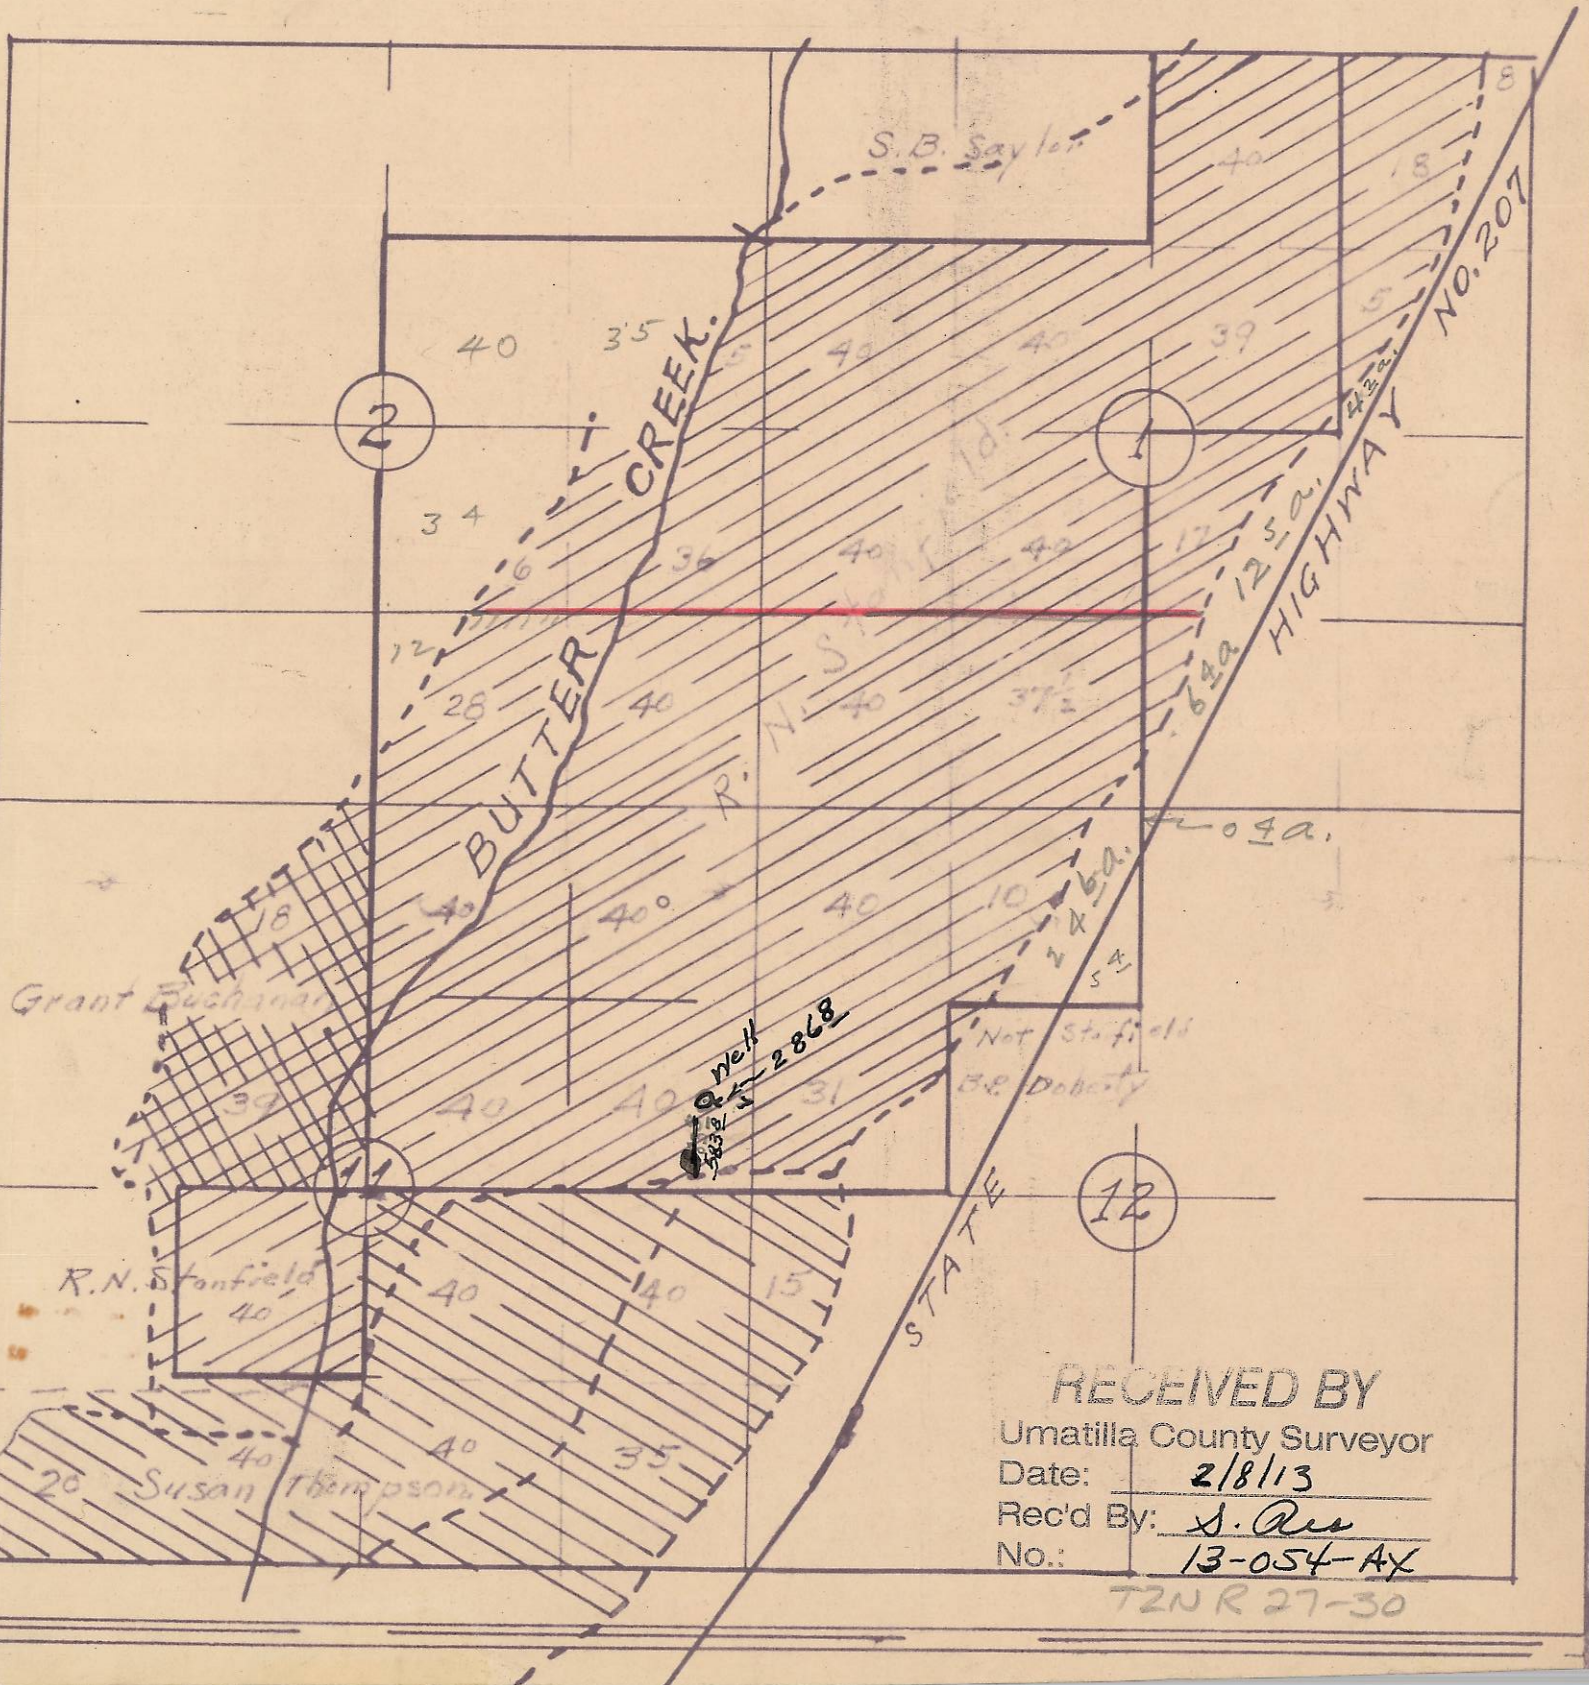

RECEIVED BY

Umatilla County Surveyor

Date: 2/8/13

Rec'd By: S. Res

No.: 13-054-AX

T2NR 27-30