D-43-A

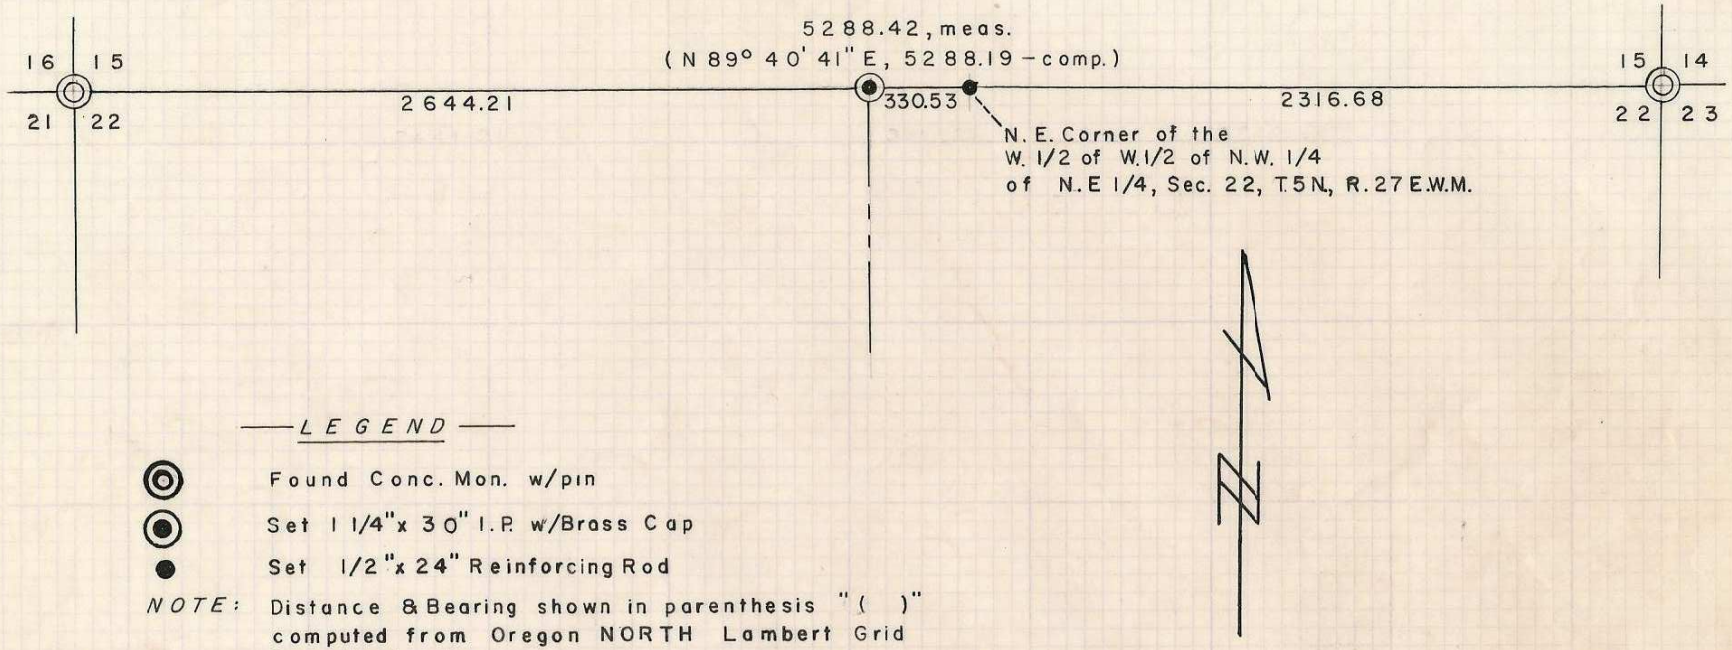

—LEGEND—

◎ Found Conc. Mon. w/pin

◉ Set 1 1/4" x 30" I.P. w/Brass Cap

● Set 1/2" x 24" Reinforcing Rod

NOTE: Distance & Bearing shown in parenthesis "( )" computed from Oregon NORTH Lambert Grid Coordinates.

REGISTERED
OREGON
LAND SURVEYOR

Ralph P. Thompson

MAY 13, 1960
RALPH P. THOMPSON
506

D-43-A x

SURVEY FOR M. SIMMONS
NORTH LINE SECTION 22
Twsp, 5 N Range 27, E.W.M.

Date: Sept. 22, 1967 | Scale: 1" = 600'

RALPH THOMPSON
REGISTERED LAND SURVEYOR
P. O. BOX 1082 PENDLETON, ORE. 97801