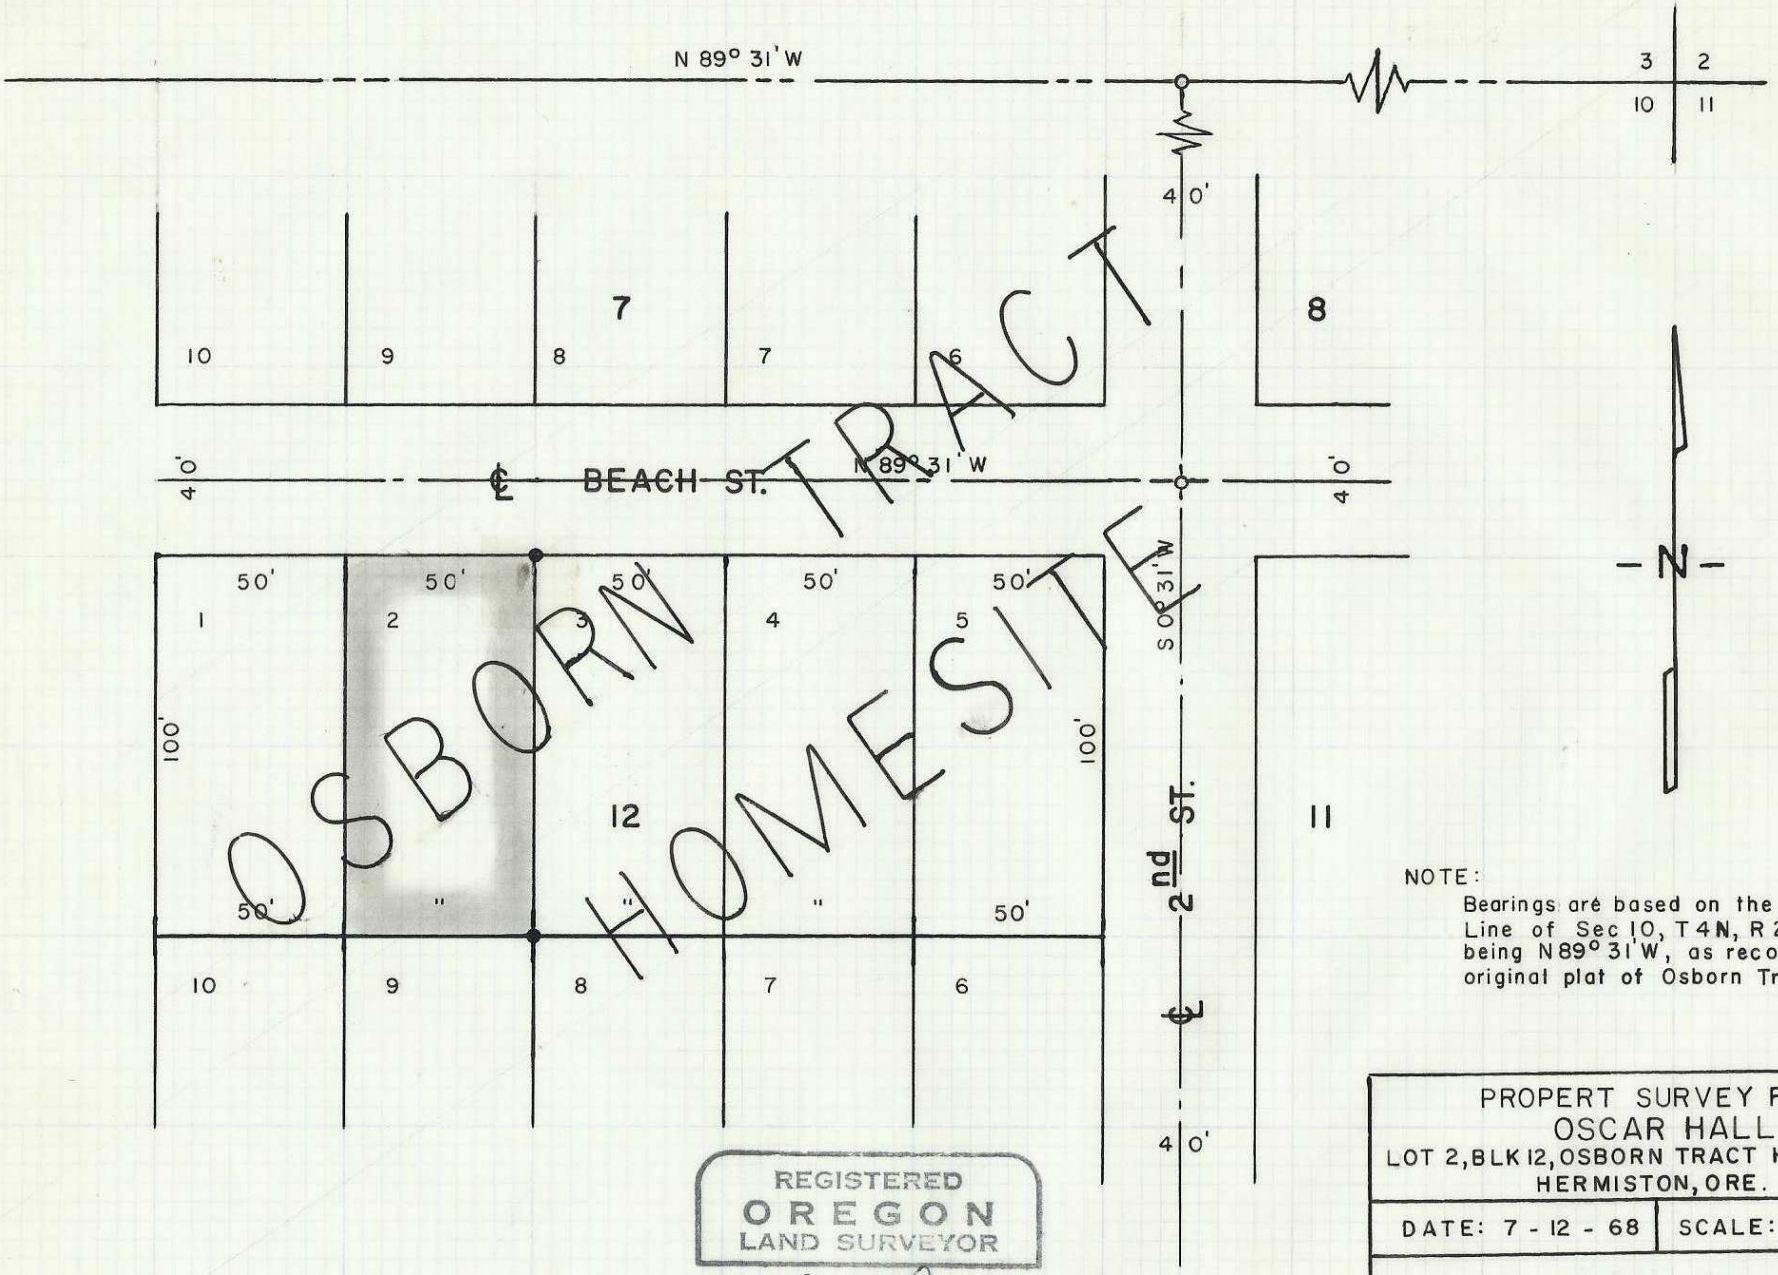

E-14-Ax

NOTE:
Bearings are based on the North Sec Line of Sec 10, T 4N, R 28E, as being N89° 31'W, as recorded on the original plat of Osborn Tract Homesite

O = I.P.'S FOUND

● = I.P.'S SET

REGISTERED
OREGON
LAND SURVEYOR

Ralph P. Thompson

MAY 13, 1960
RALPH P. THOMPSON
506

PROPERT SURVEY FOR
OSCAR HALL
LOT 2, BLK 12, OSBORN TRACT HOMESITE
HERMISTON, ORE.

DATE: 7 - 12 - 68 | SCALE: 1" = 50'

RALPH THOMPSON
REGISTERED LAND SURVEYOR
P. O. BOX 1082 PENDLETON, ORE. 97801

E-14-Ax