



REGISTERED  
**OREGON**  
 LAND SURVEYOR

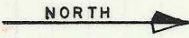

*Ralph P. Thompson*

MAY 13, 1960  
 RALPH P. THOMPSON  
 506

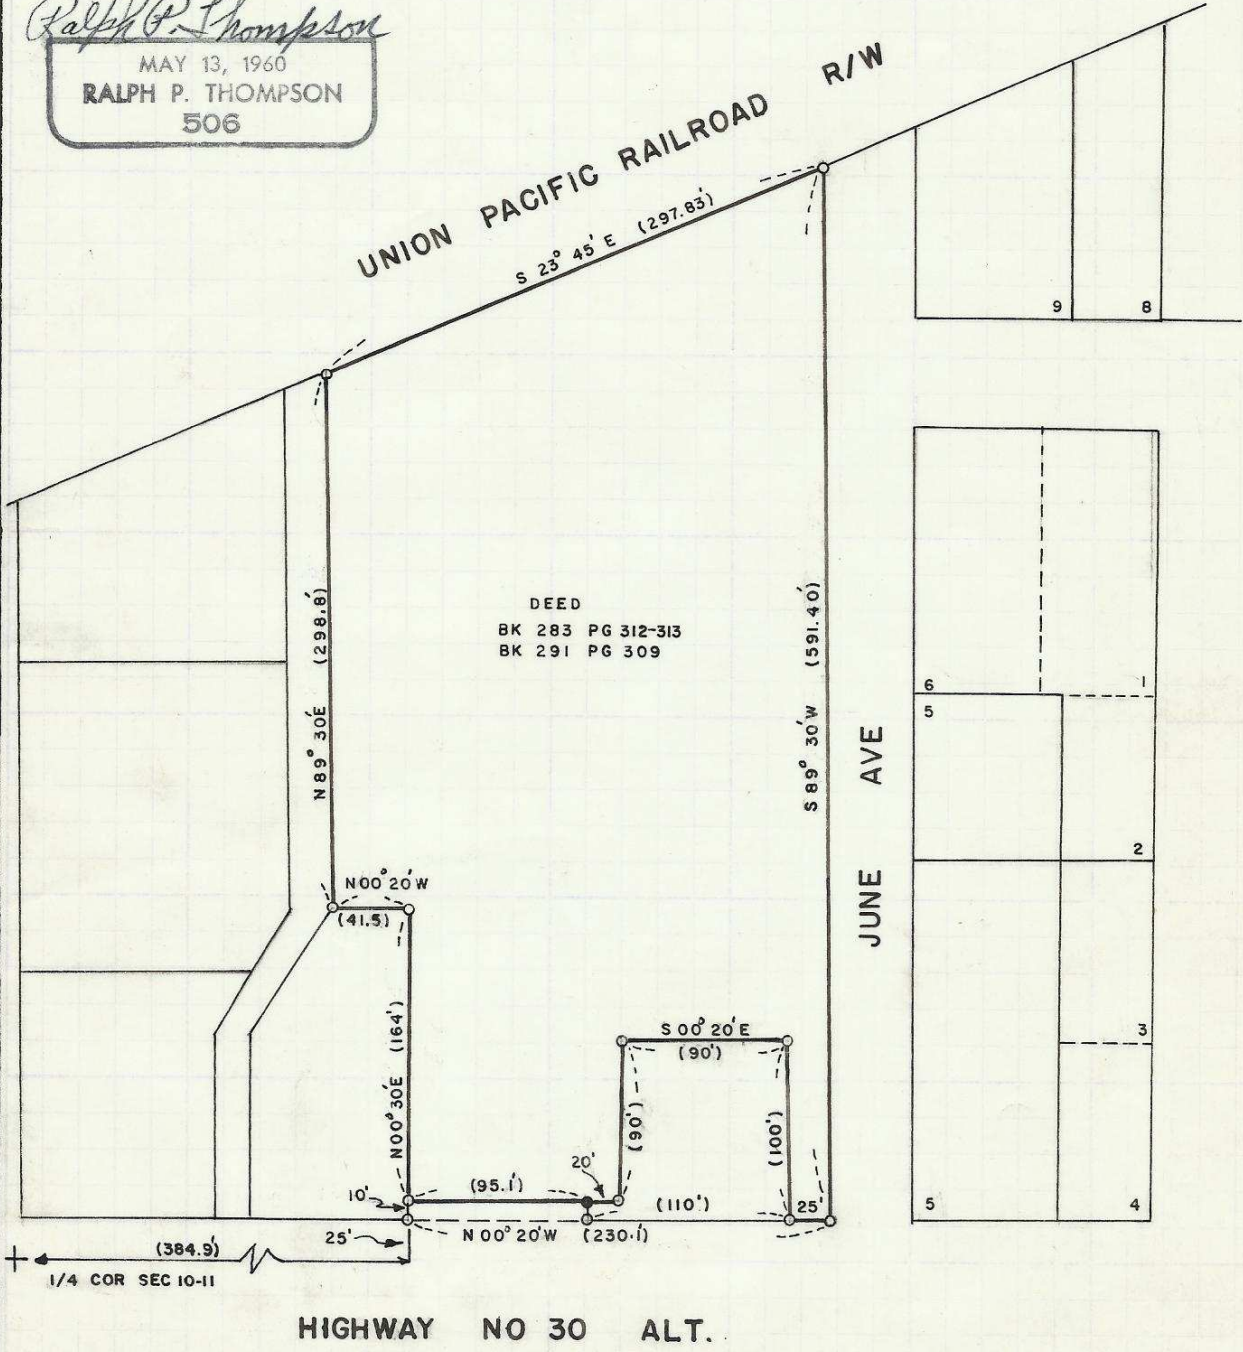

- SET 1/2" X 24" REBAR
- SET CONC NAIL

G-3

SURVEY FOR J.E. DICKENS  
 HERMISTON, OREGON  
 SE 1/4, NE 1/4, SEC 10, T4N, R28E

DATE: JUNE 5, 1970  
 SCALE: 1" = 100'

RALPH THOMPSON  
 REGISTERED LAND SURVEYOR  
 P.O. BOX 1082  
 PENDLETON, OREGON

G-3-Ax