

H-46

T.6 N. R.35 E. W.M.

ALLEN J. LOMMASSON	
Registered Surveyor	
142 THORNE	
WALLA WALLA, WASHINGTON	
Survey for	
W. C. Boyd	
2/22/72	

H-46-Ax




Scale: 1" = 100'

REGISTERED PROFESSIONAL LAND SURVEYOR

A. J. Lommasson

OREGON OCTOBER 4, 1957 A. J. LOMMASSON 422

Harlind Krumbah

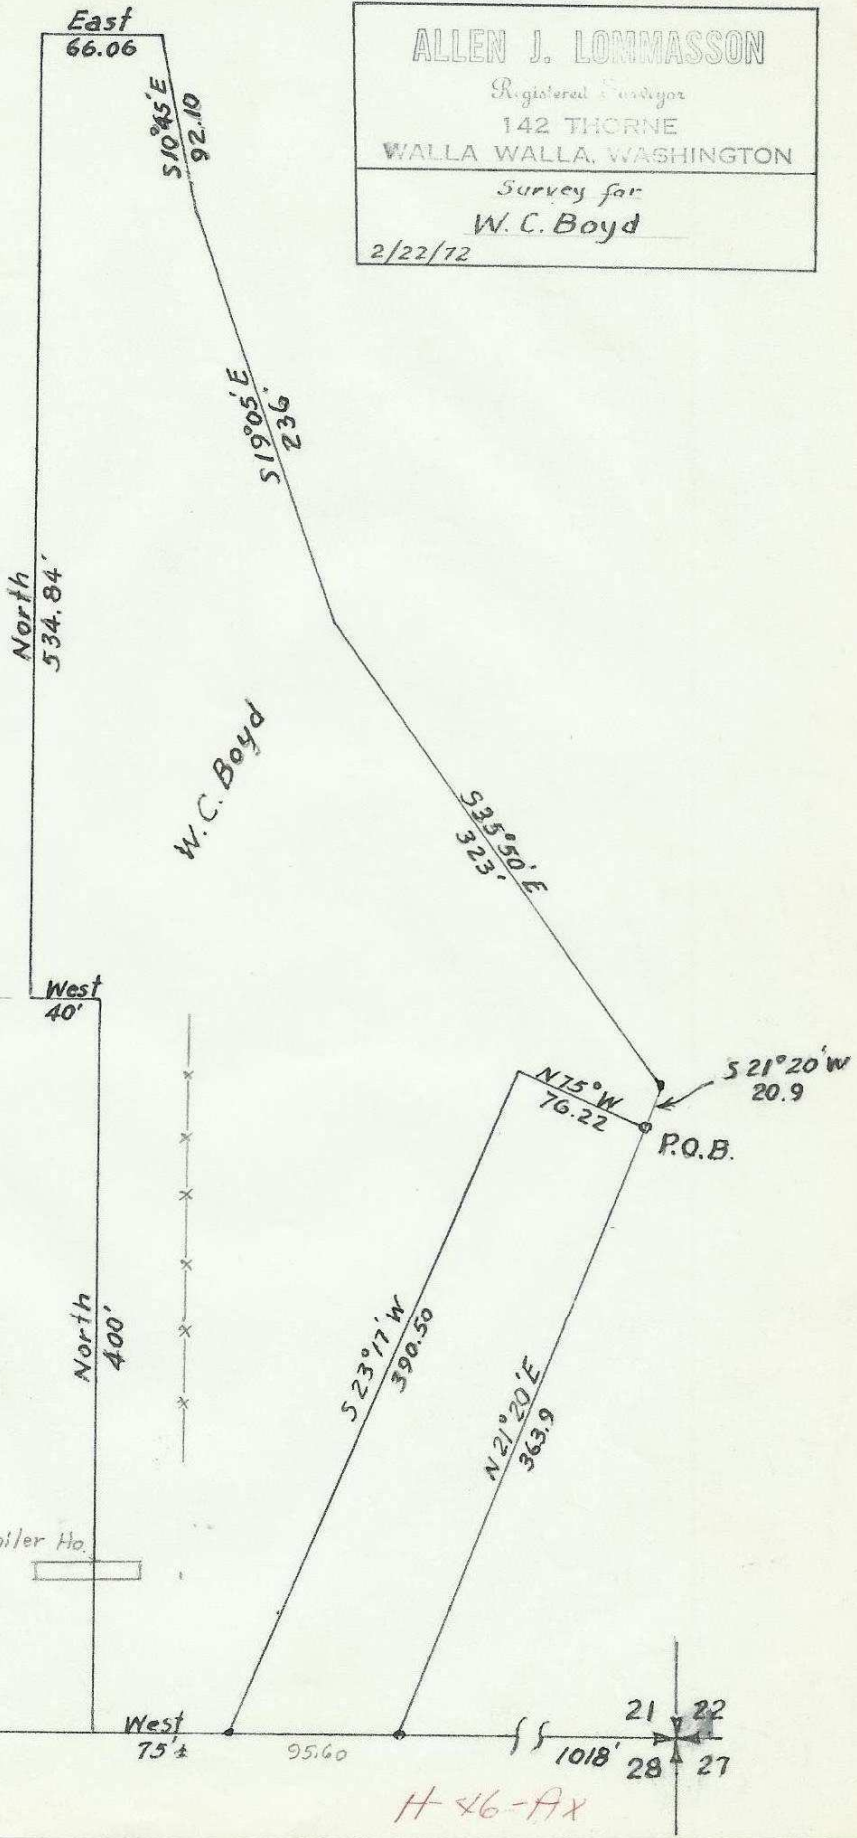

H-46-Ax