
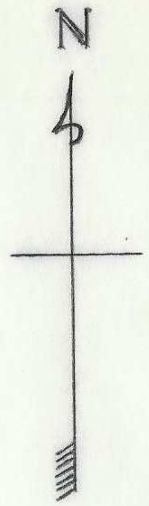


Sec. 24, T.6N, R.35E.

H-91-A₂

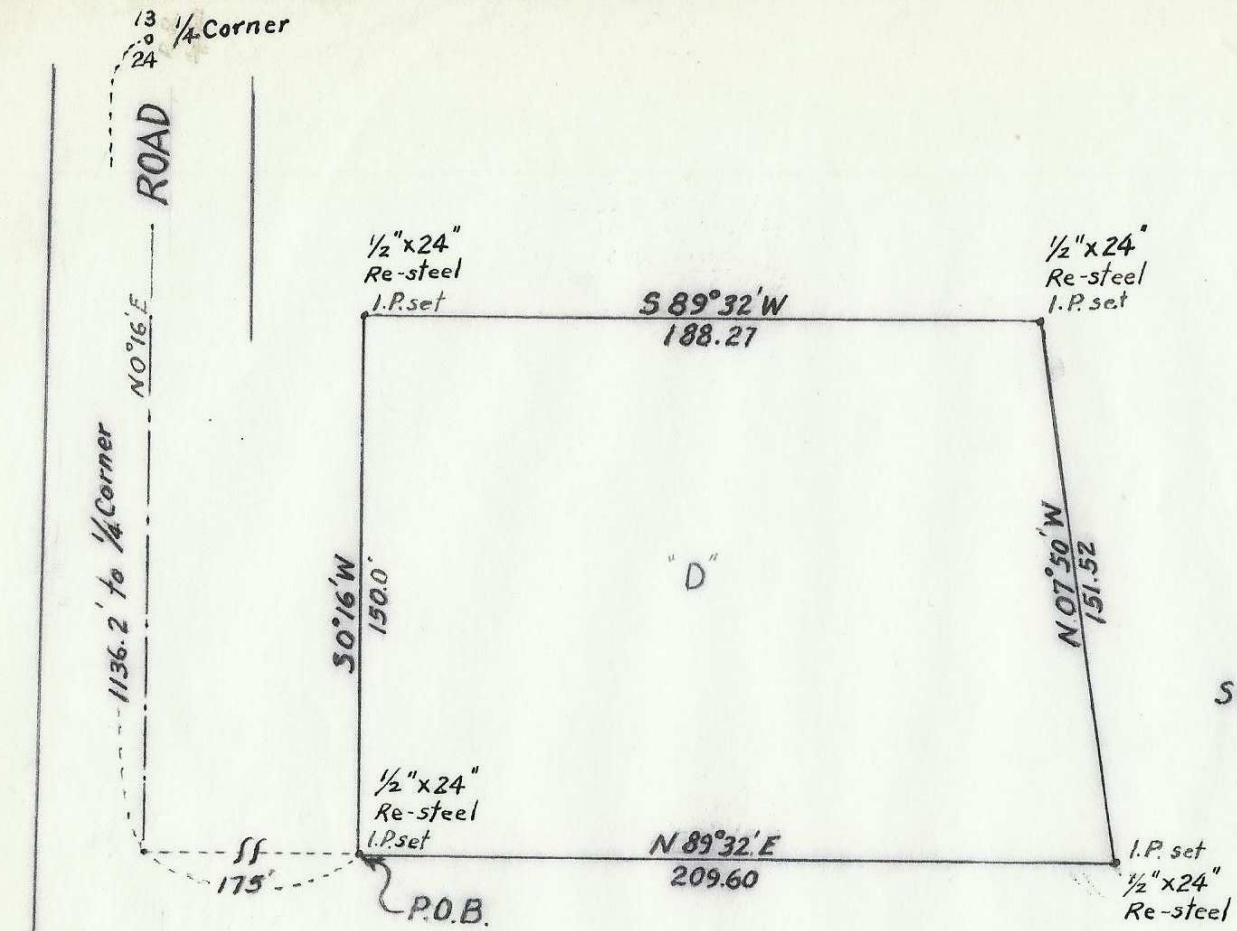

Scale: 1" = 50'

Note: Bearings shown are based on centerline of Tumulum Road which is N 0° 16' E.

REGISTERED PROFESSIONAL LAND SURVEYOR

A. J. Lommasson

OREGON
OCTOBER 4, 1957
A. J. LOMMASSON
422

ALLEN J. LOMMASSON
Registered Surveyor
142 THORNE
WALLA WALLA, WASHINGTON

Survey for
JOHN R. STARLIN
4/8/72

H-91