



Rounded Stone
mid 1/6

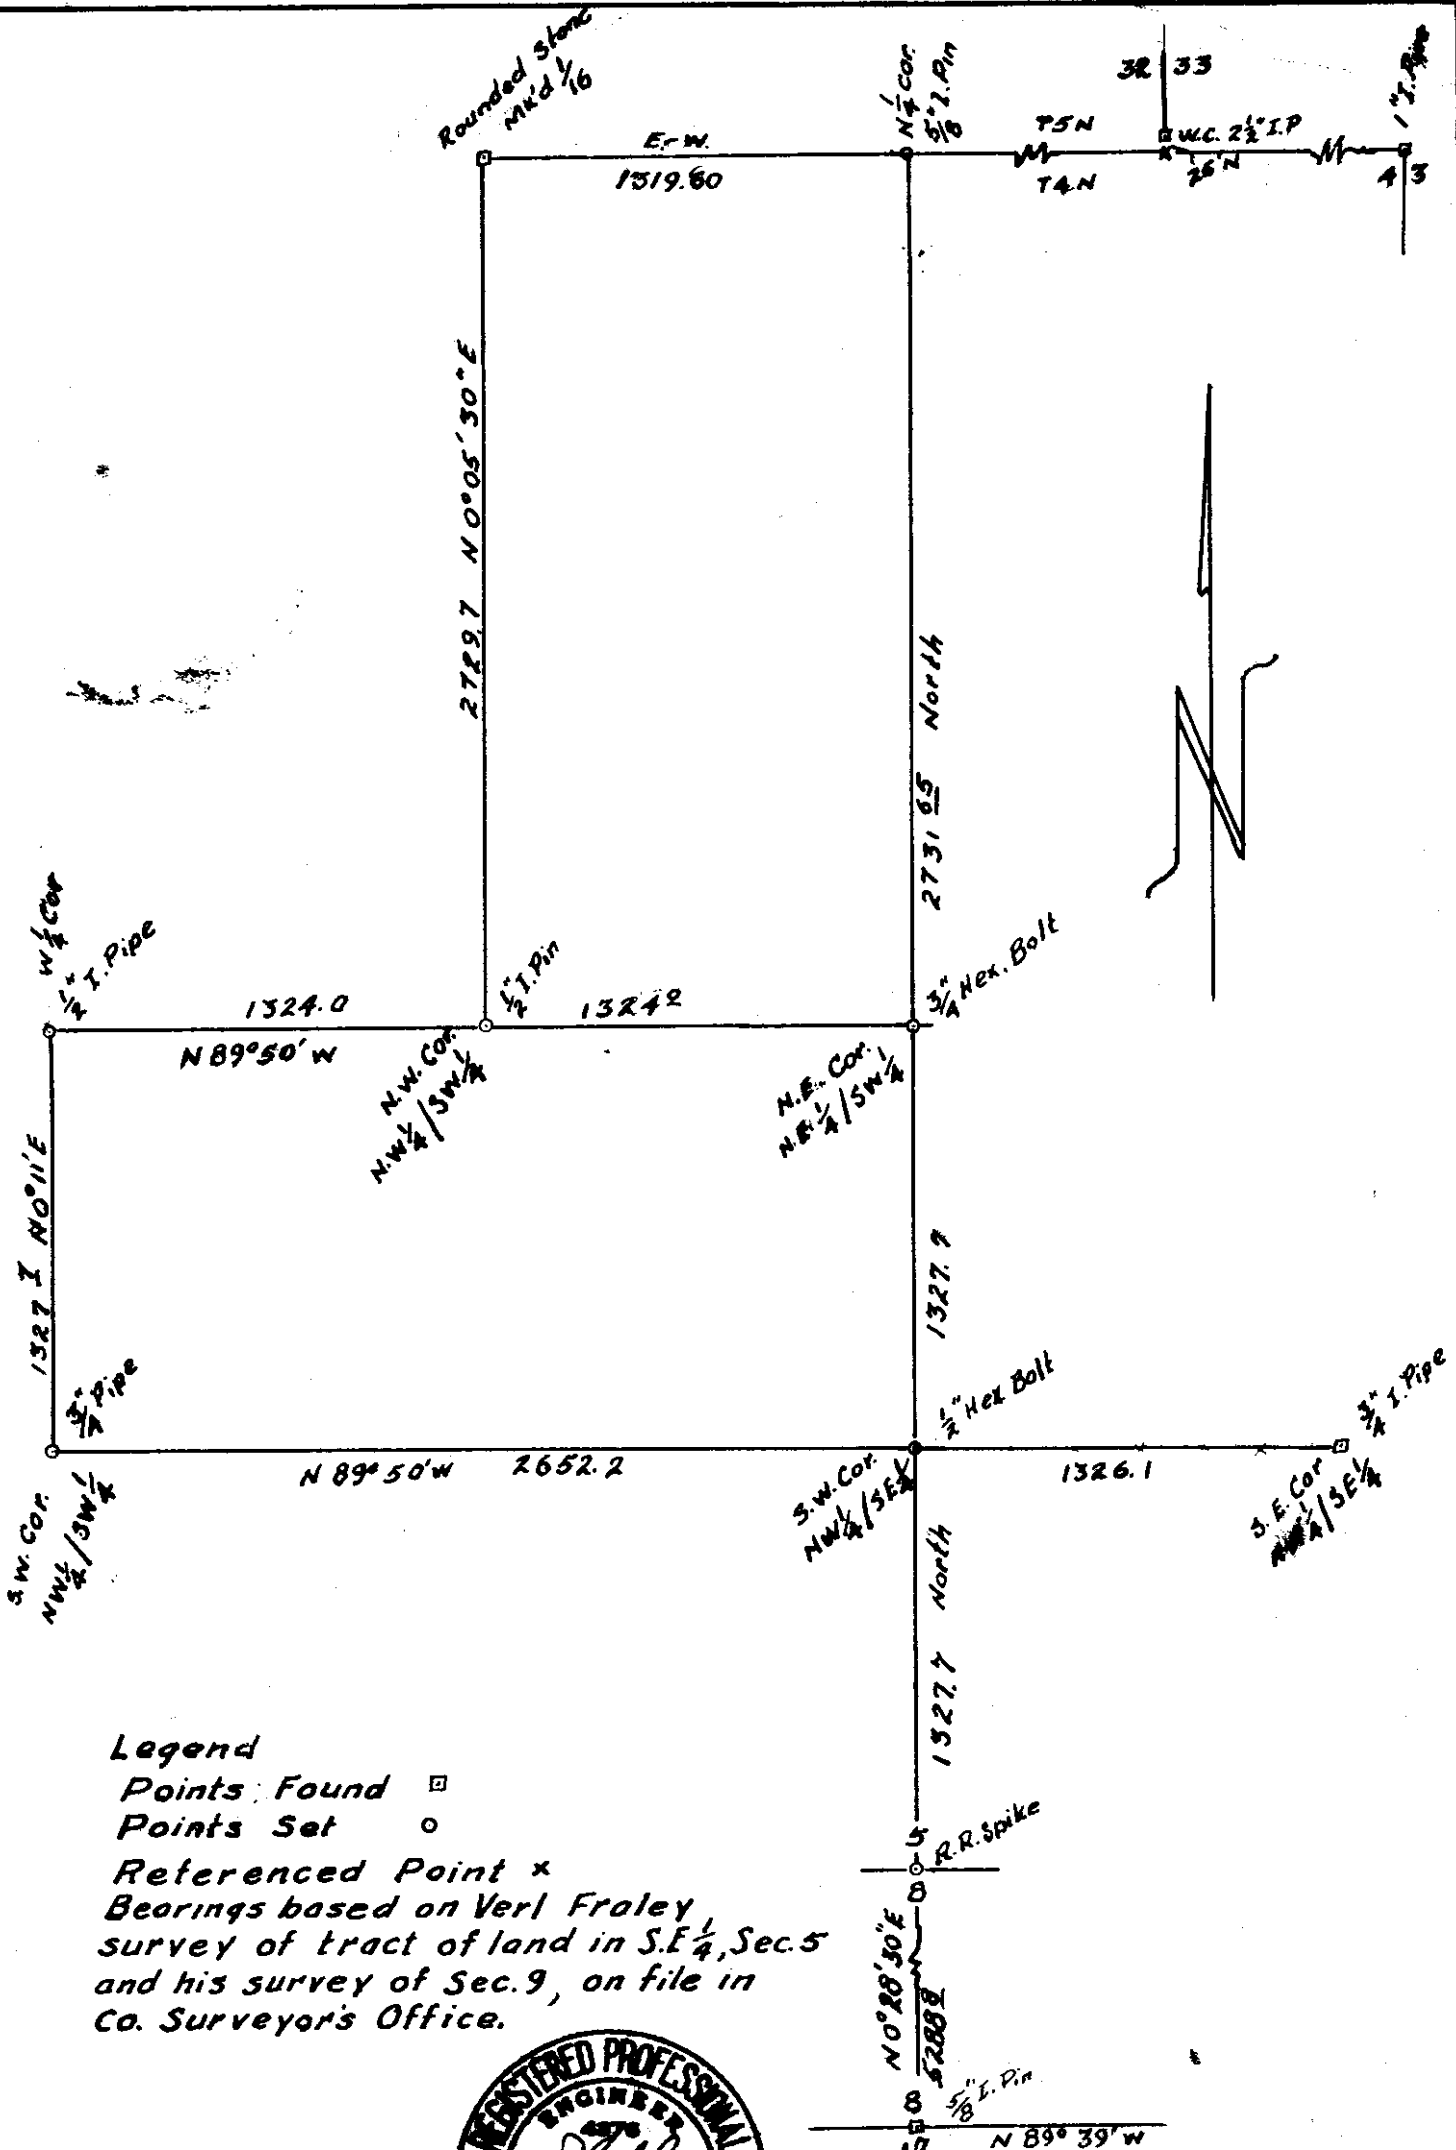

Legend

- Points Found \square
 - Points Set \circ
 - Referenced Point \times
- Bearings based on Verl Fraley
survey of tract of land in S.E. 1/4, Sec. 5
and his survey of Sec. 9, on file in
Co. Surveyor's Office.

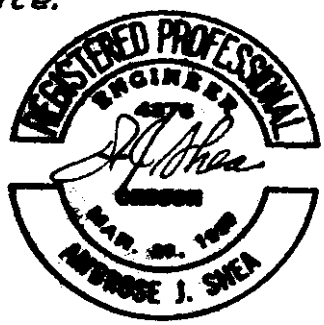

SURVEY of E 1/2 of N.W. 1/4 & N 1/2 of SW 1/4
SECTION 5, T4N, R28E. W.M.
FOR HAROLD BRYSON
Scale 1" = 600' Date 10/14/72