


H-202-A6

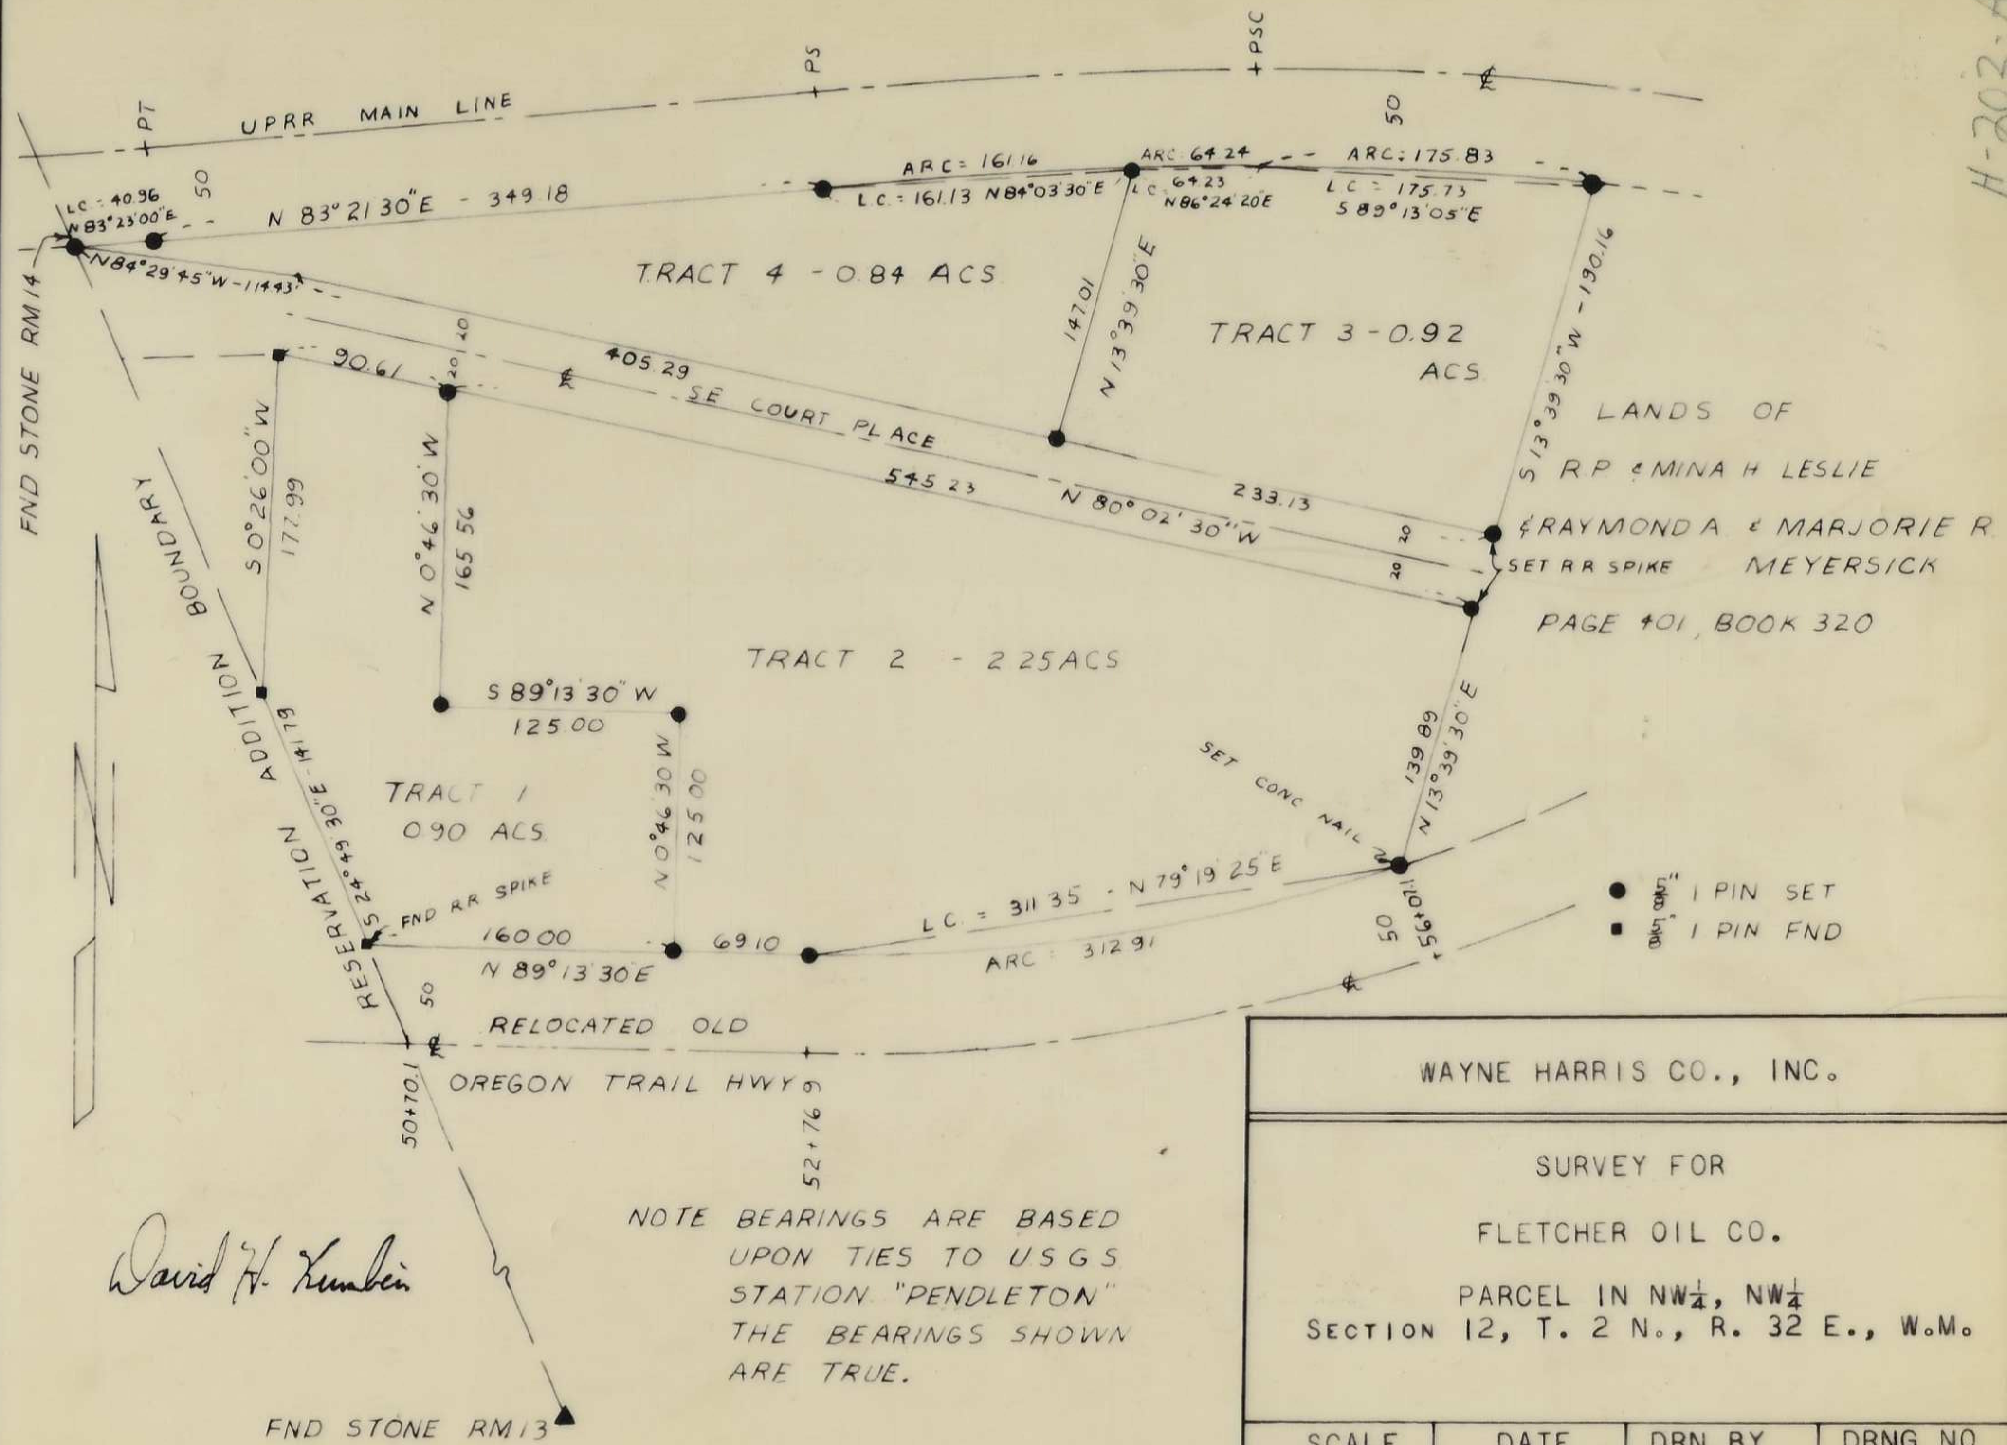

David H. Kumbin

NOTE BEARINGS ARE BASED
UPON TIES TO USGS
STATION "PENDLETON"
THE BEARINGS SHOWN
ARE TRUE.

WAYNE HARRIS CO., INC.			
SURVEY FOR			
FLETCHER OIL CO.			
PARCEL IN NW $\frac{1}{4}$, NW $\frac{1}{4}$			
SECTION 12, T. 2 N., R. 32 E., W.M.			
SCALE	DATE	DRN BY	DRNG NO
1" = 100'	10-20-72	DHK	72-348

H 202