H-241

H-241-H

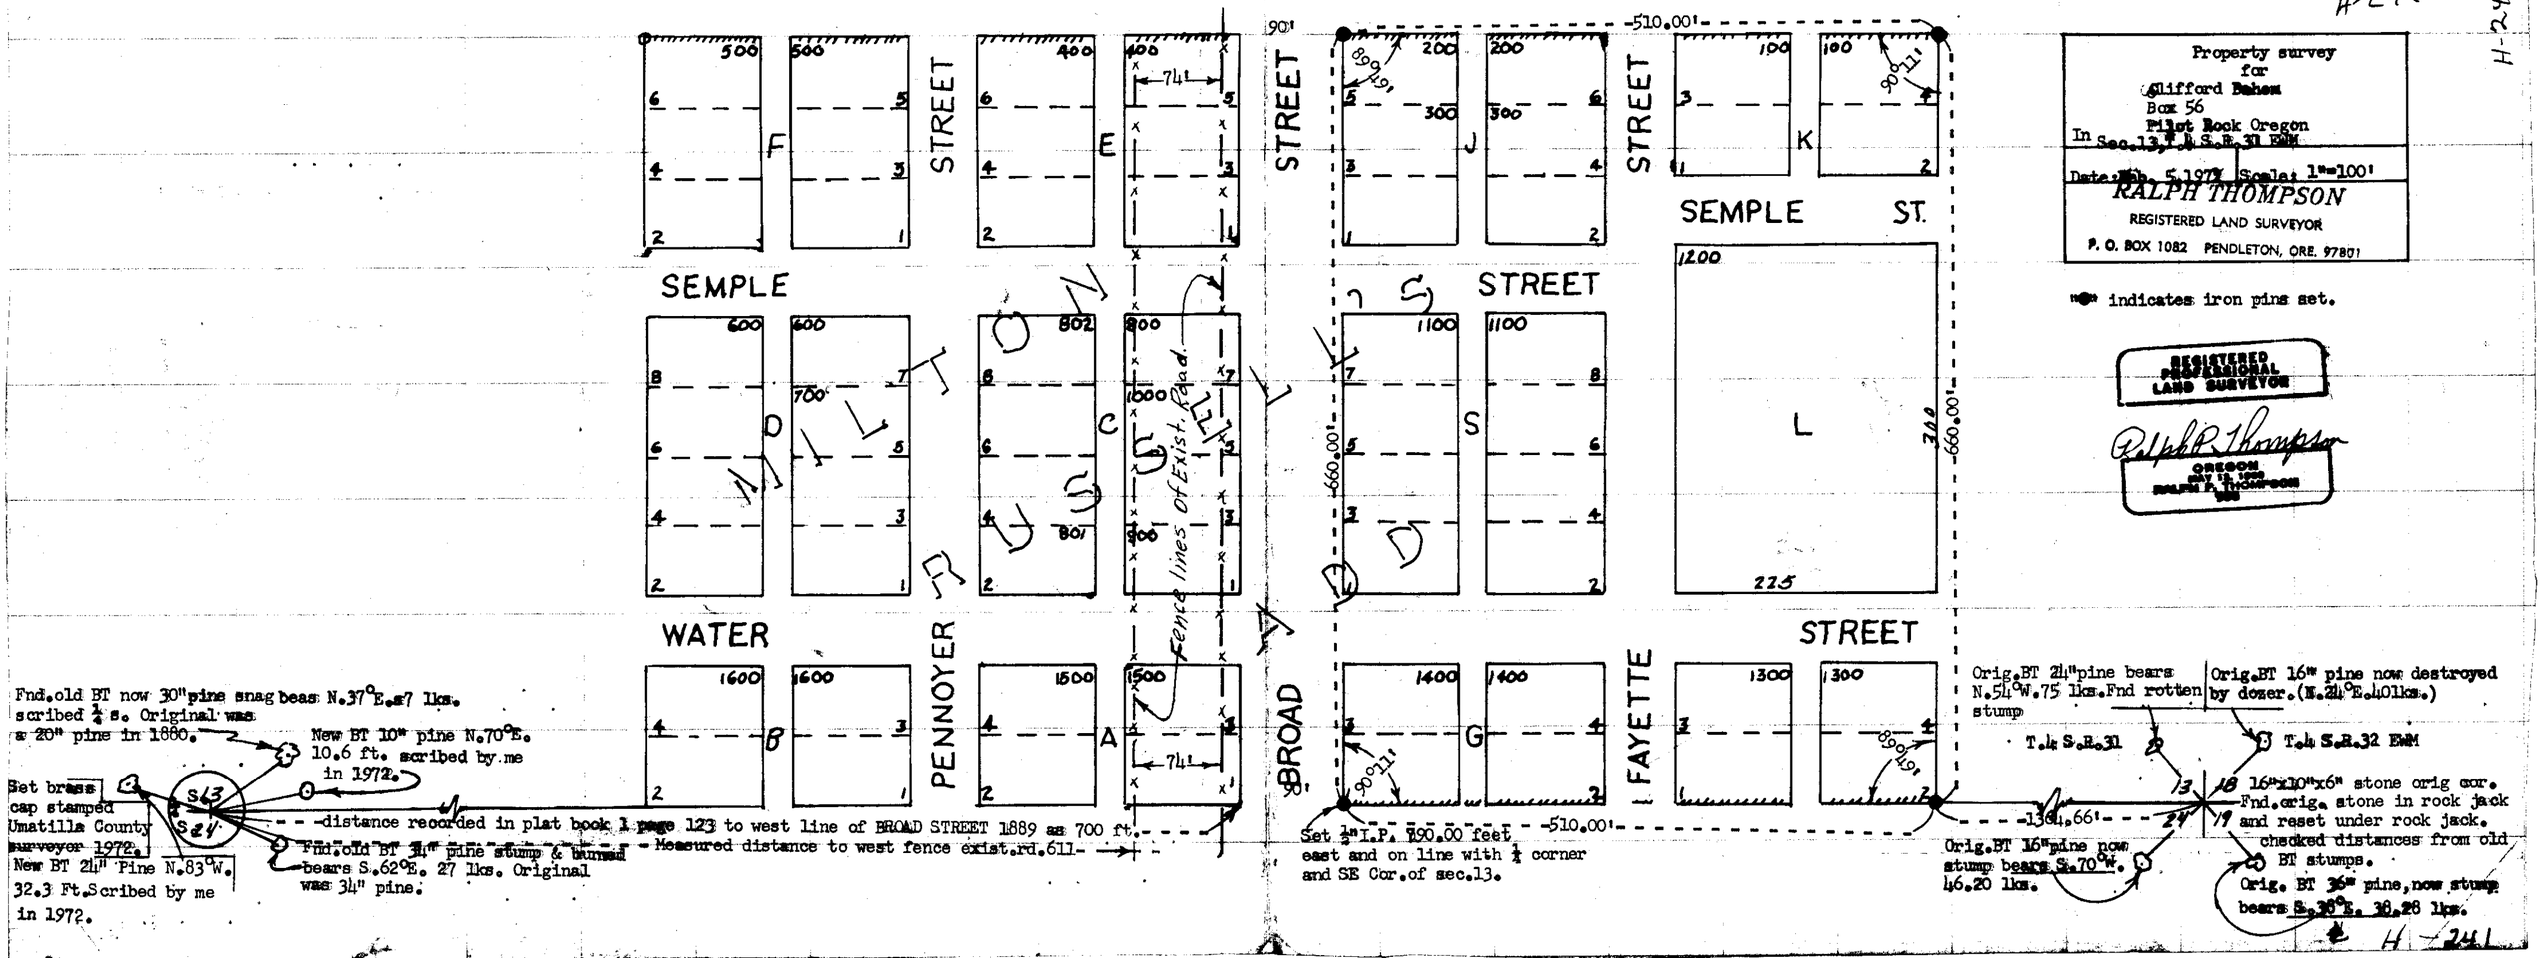

Property survey
for
Clifford Dahem
Box 56
Pilot Rock Oregon
In Sec.13, T.4 S.R.31 EWM

Date: Feb. 5 1972 Scale: 1"=100'

RALPH THOMPSON
REGISTERED LAND SURVEYOR
P. O. BOX 1082 PENDLETON, ORE. 97801

"●" indicates iron pins set.

REGISTERED PROFESSIONAL LAND SURVEYOR
Ralph R. Thompson
OREGON
MAY 19, 1972
RALPH R. THOMPSON
1082

H-241