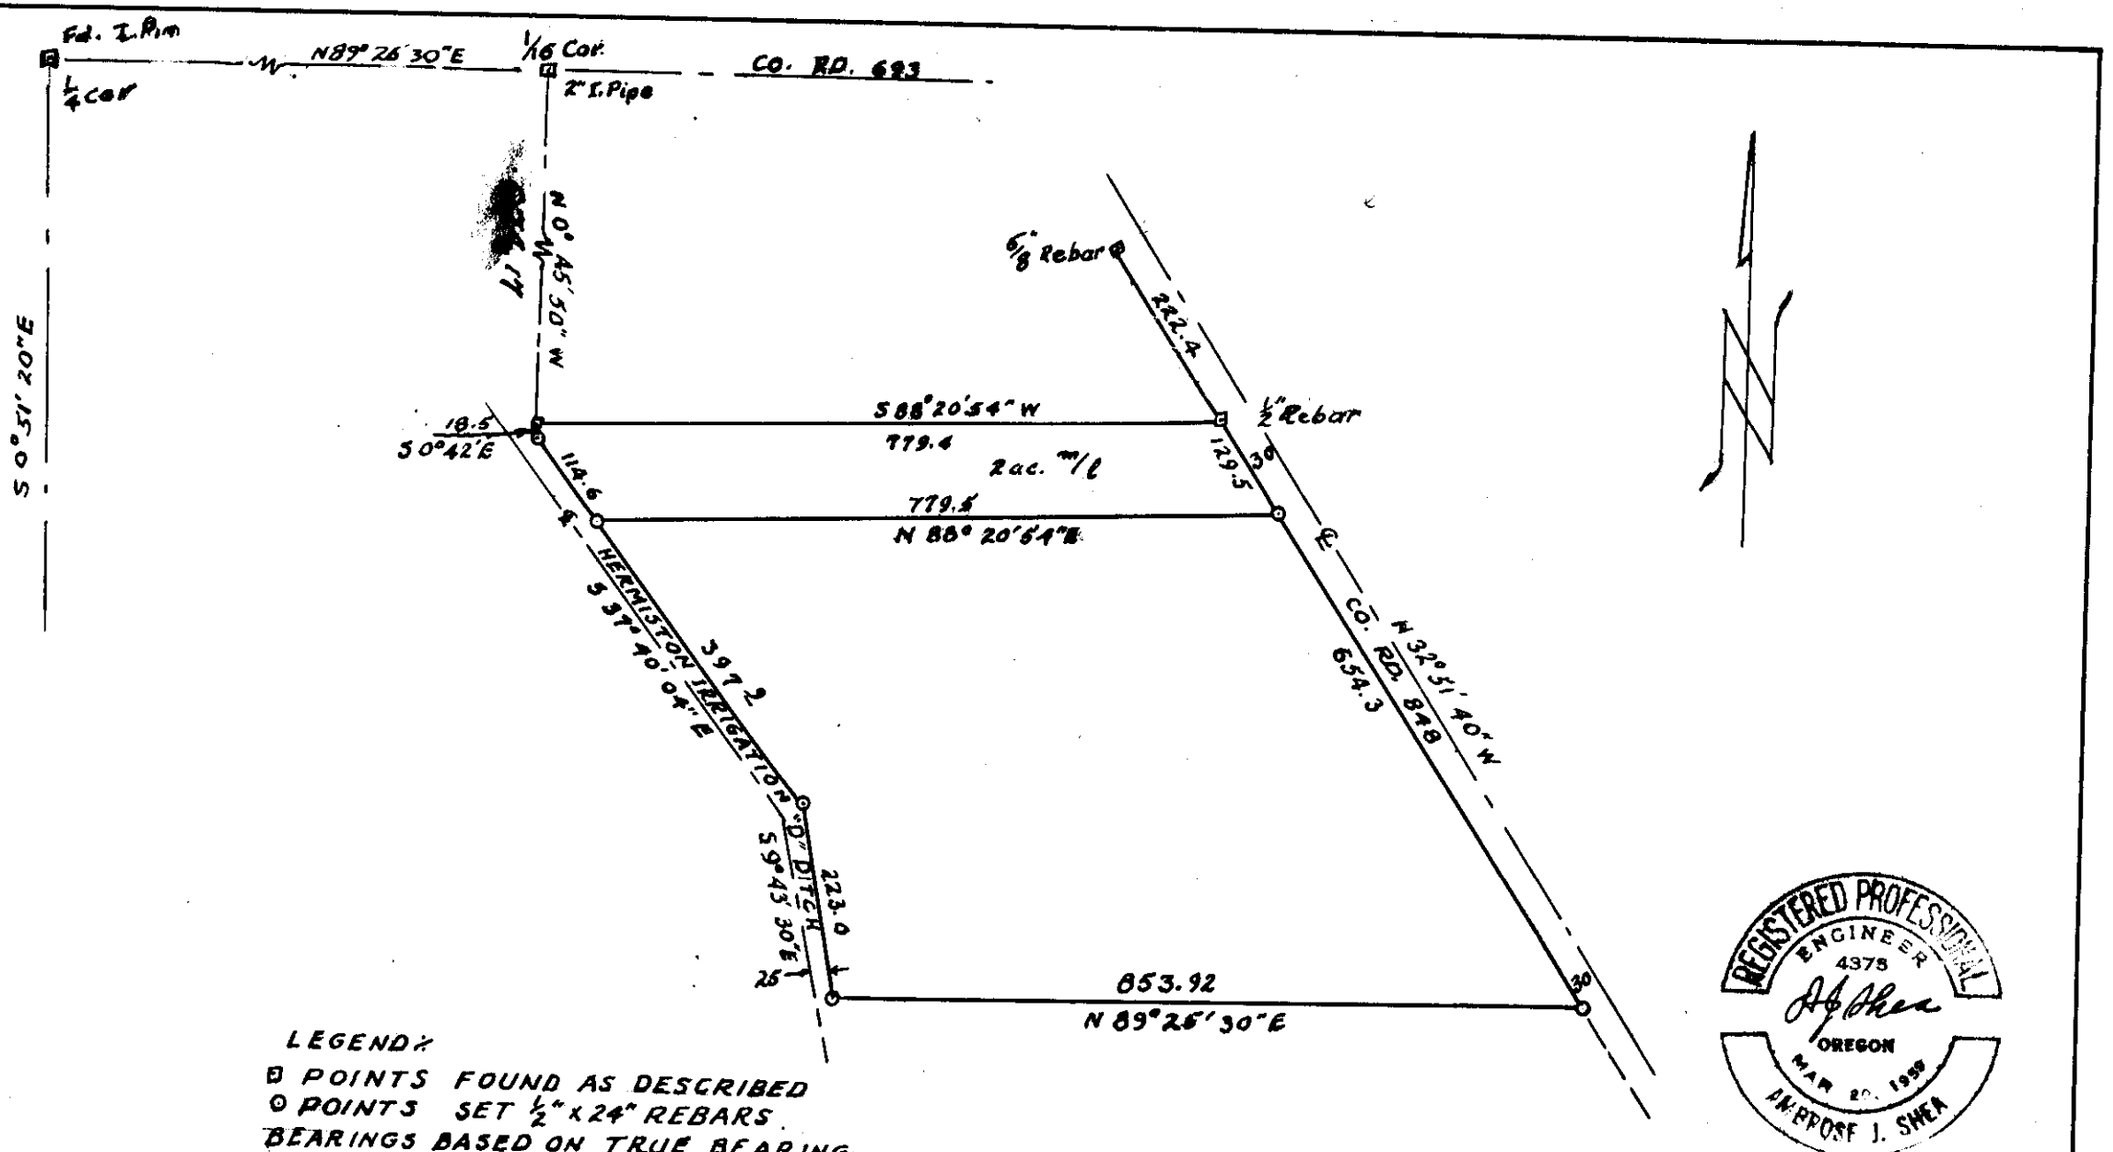

LEGEND:
- ▫ POINTS FOUND AS DESCRIBED
- ⊙ POINTS SET 1/2" x 24" REBARS

BEARINGS BASED ON TRUE BEARING OF W. LINE OF SECTION BEING S 0°51'20"E REFEERED TO U.S.C.&G GRID

PLAT OF SURVEY
IN NE 1/4 of SW 1/4 SEC. 3, T4N., R28E. W.M.
FOR N.C. PEDERSON
SCALE 1" = 200' 3/15/75

J-139-A

J-139