


N.W. KINGS AVE.
N 89° 10' 30" E.

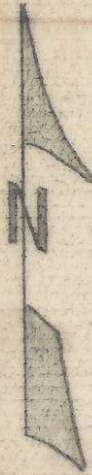

FND 1/2 IP

60.00

SET 1/2 IP

60.00

FND 5/8

FND 5/8

30

30

25

25

LOT 21

LOT 21

LOT 3

(3)

(6)

120.00

120.00

122.00

NOTE

BERRING BASED
ON PLAT OF
WEST HILLS ADD.
TO CITY OF
PENDLETON, ORE.

N 00° 49' 30" W
N.W. JOHNS AVE.

PLAT DIST. = 131.85
MEASURED DIST. = 131.80

SET 1/2 IP

60.00

SET 1/2 IP

25

25

FND 5/8

L-34

REGISTERED
PROFESSIONAL
LAND SURVEYOR

David H. Krumbein

OREGON
JULY 17, 1970
DAVID H. KRUMBEIN
933

KRUMBEIN ENGINEERING CO.

ENGINEERS - SURVEYORS - PLANNERS
216 S.E. 1st, Pendleton, Oregon

SURVEY FOR
PENDLETON HOUSING CORP
LOT 21, BLOCK 3, WEST HILLS

SCALE
1" = 20'

DATE
1-26-76

DRN. BY
T.E.H.

CKD. BY
D.H.K.

DRNG. NO.
76-26A

L-34-AV