
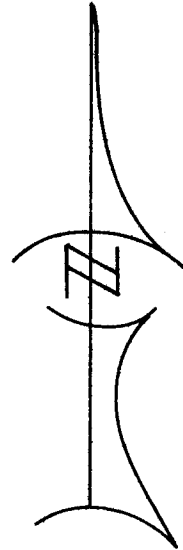


SUNSET AVENUE

SEVENTH STREET

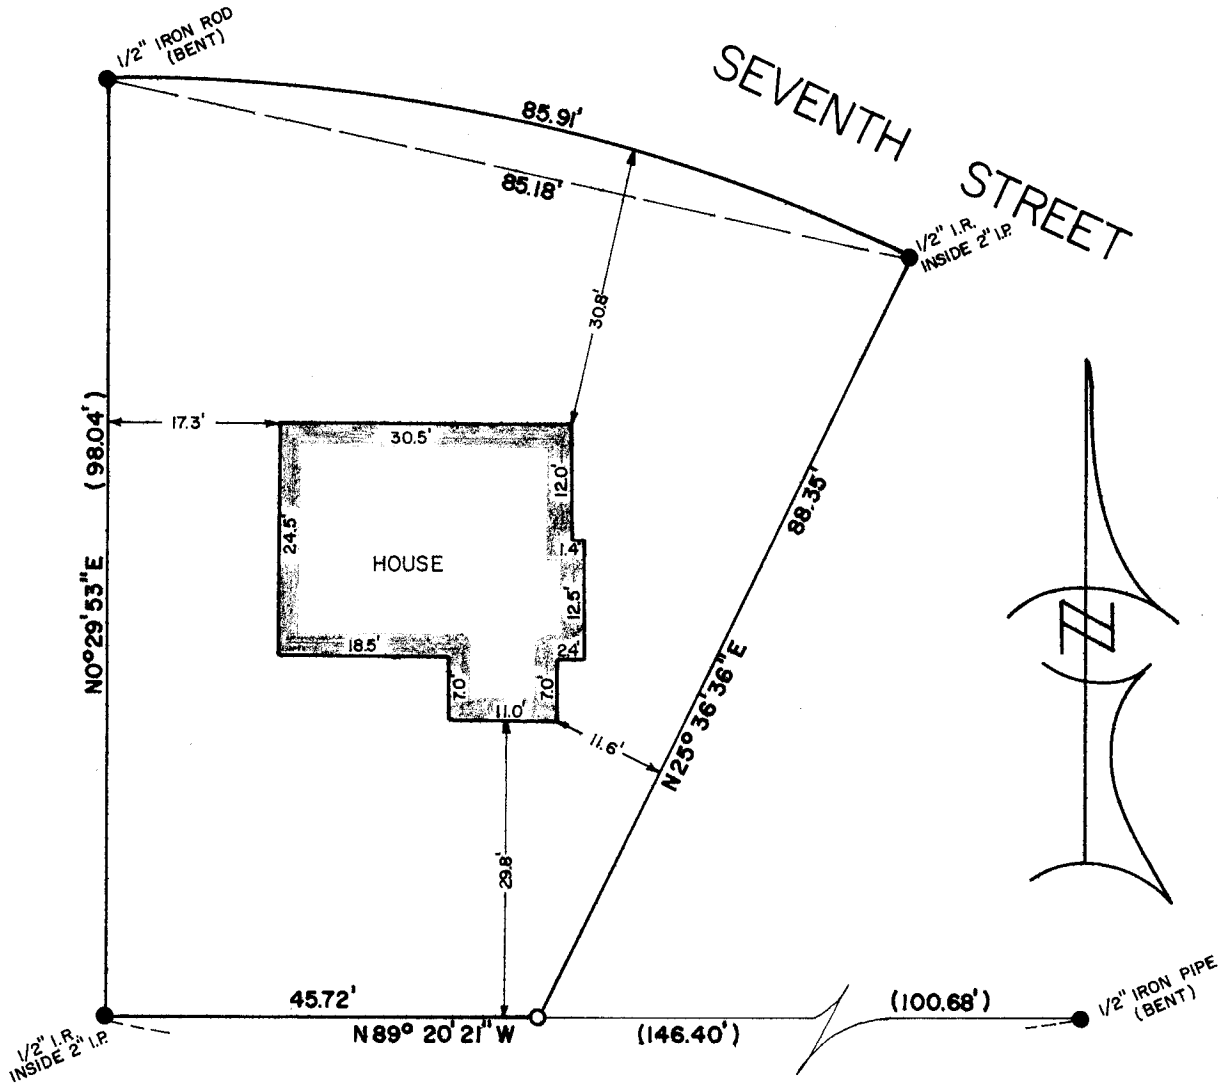

M-023-AX

SURVEY FOR: GEORGE CORRIGAN

LOCATION:

LOT 2, BLOCK 3, HERMISTON PARK PLAT NUMBER ONE  
SEC. 11, T 4 N, R 28 E, W.M., UMATILLA COUNTY, OREGON

DATE: 12-30-76

SCALE: 1" = 20'

● MONUMENTS FOUND

(000) OF RECORD

○ 1/2" IRON RODS SET

JOB NO. S7612382

REGISTERED  
PROFESSIONAL  
LAND SURVEYOR

*G. Dennis Edwards*

OREGON  
JULY 16, 1971  
G. DENNIS EDWARDS  
951

EDWARDS SURVEYING  
567-3336

P. O. Box 763  
Hermiston, Ore.