
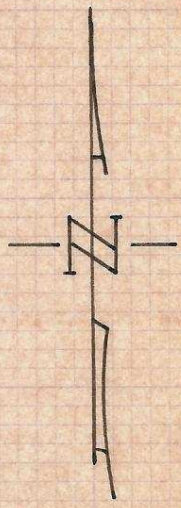


8 | 9 (980)
 17 | 16 974.78
 (S. 89° 41' 50" E. 2640.76')

9
 16
 1/4 Cor.

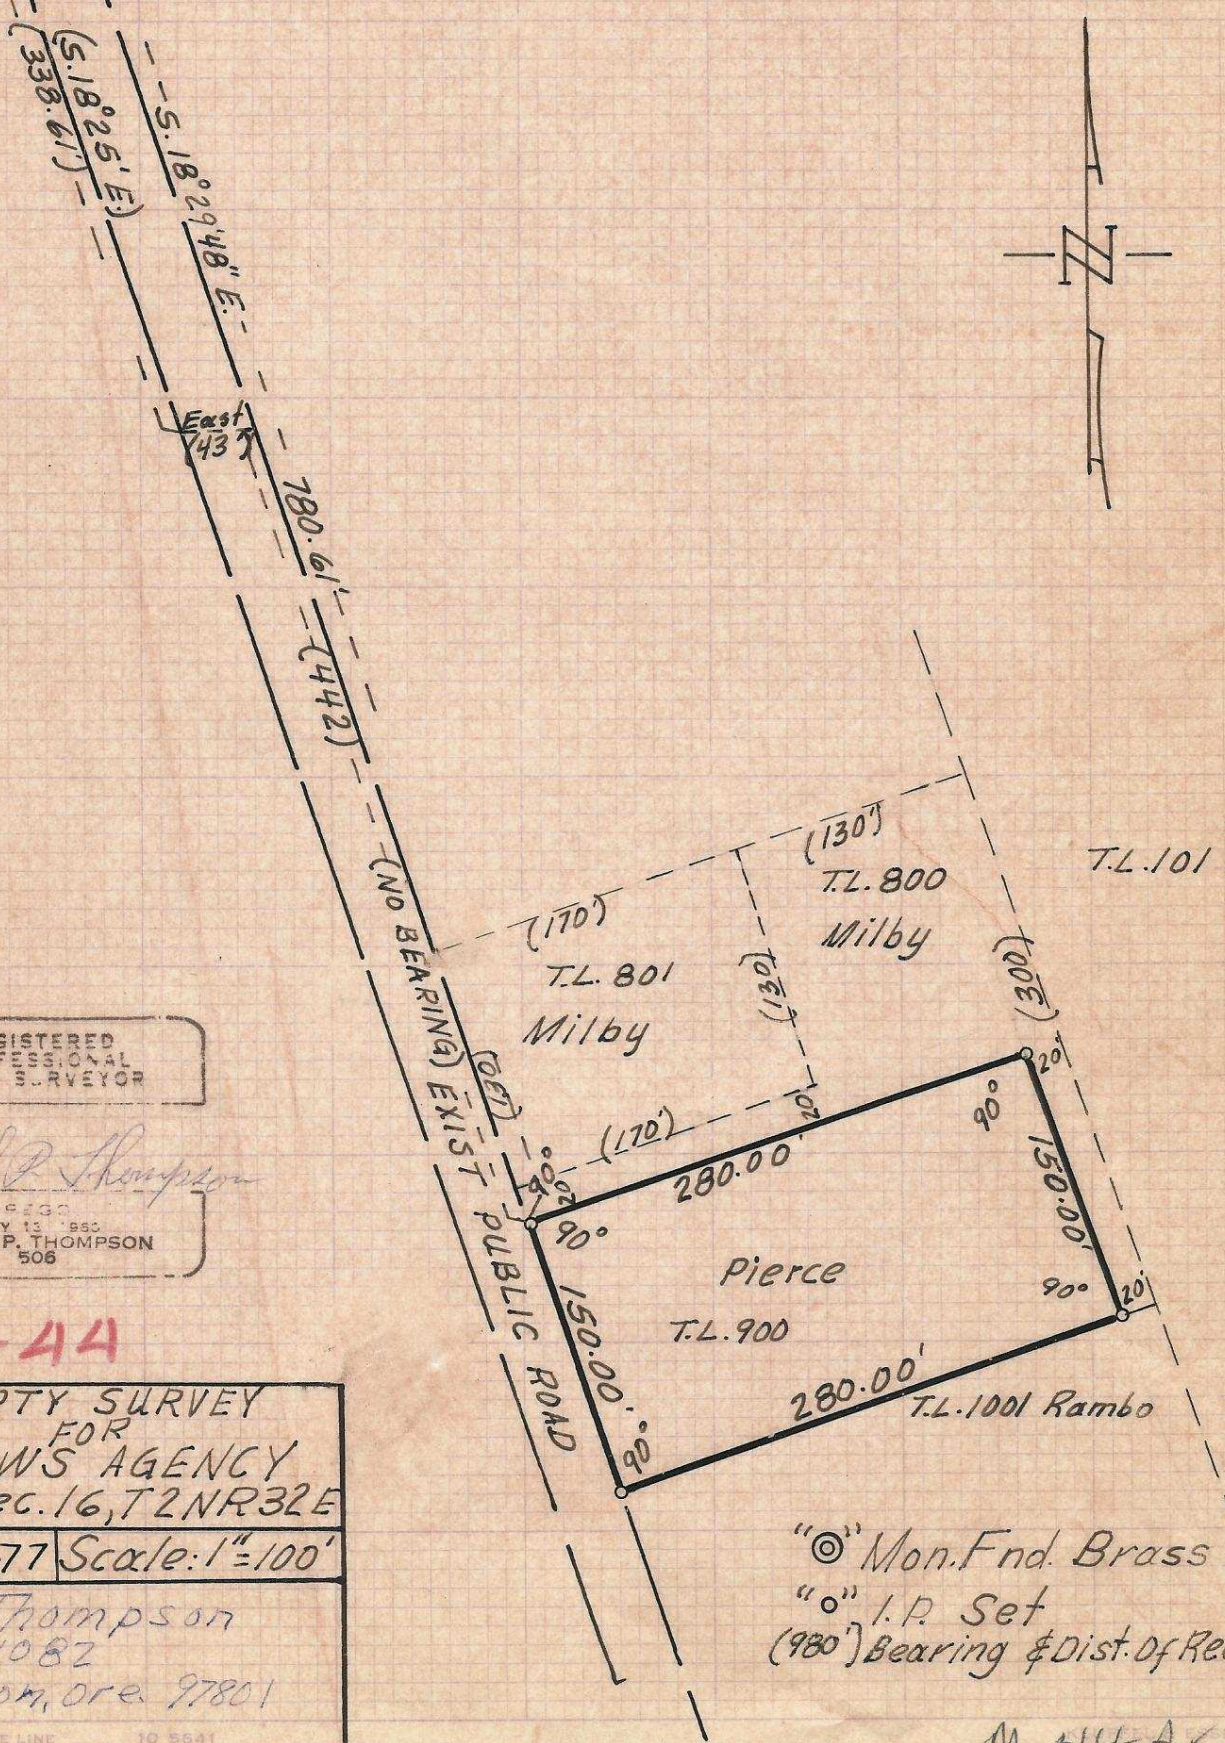

REGISTERED
 PROFESSIONAL
 LAND SURVEYOR

Ralph P. Thompson
 1930
 MAY 13 '55
 RALPH P. THOMPSON
 506

M-44

PROPERTY SURVEY
 FOR
 MATHEWS AGENCY
 in NW 1/4 Sec. 16, T2NR32E

Date: 1-30-77 Scale: 1"=100'

Ralph Thompson
 P.O. BOX 1082
 Pendleton, Ore. 97801

"⊙" Mon. Fnd. Brass Cap
 "o" I.P. Set
 (980') Bearing & Dist. of Record.

M-44-A8