


Q-66-Ax

Wayne A Harris

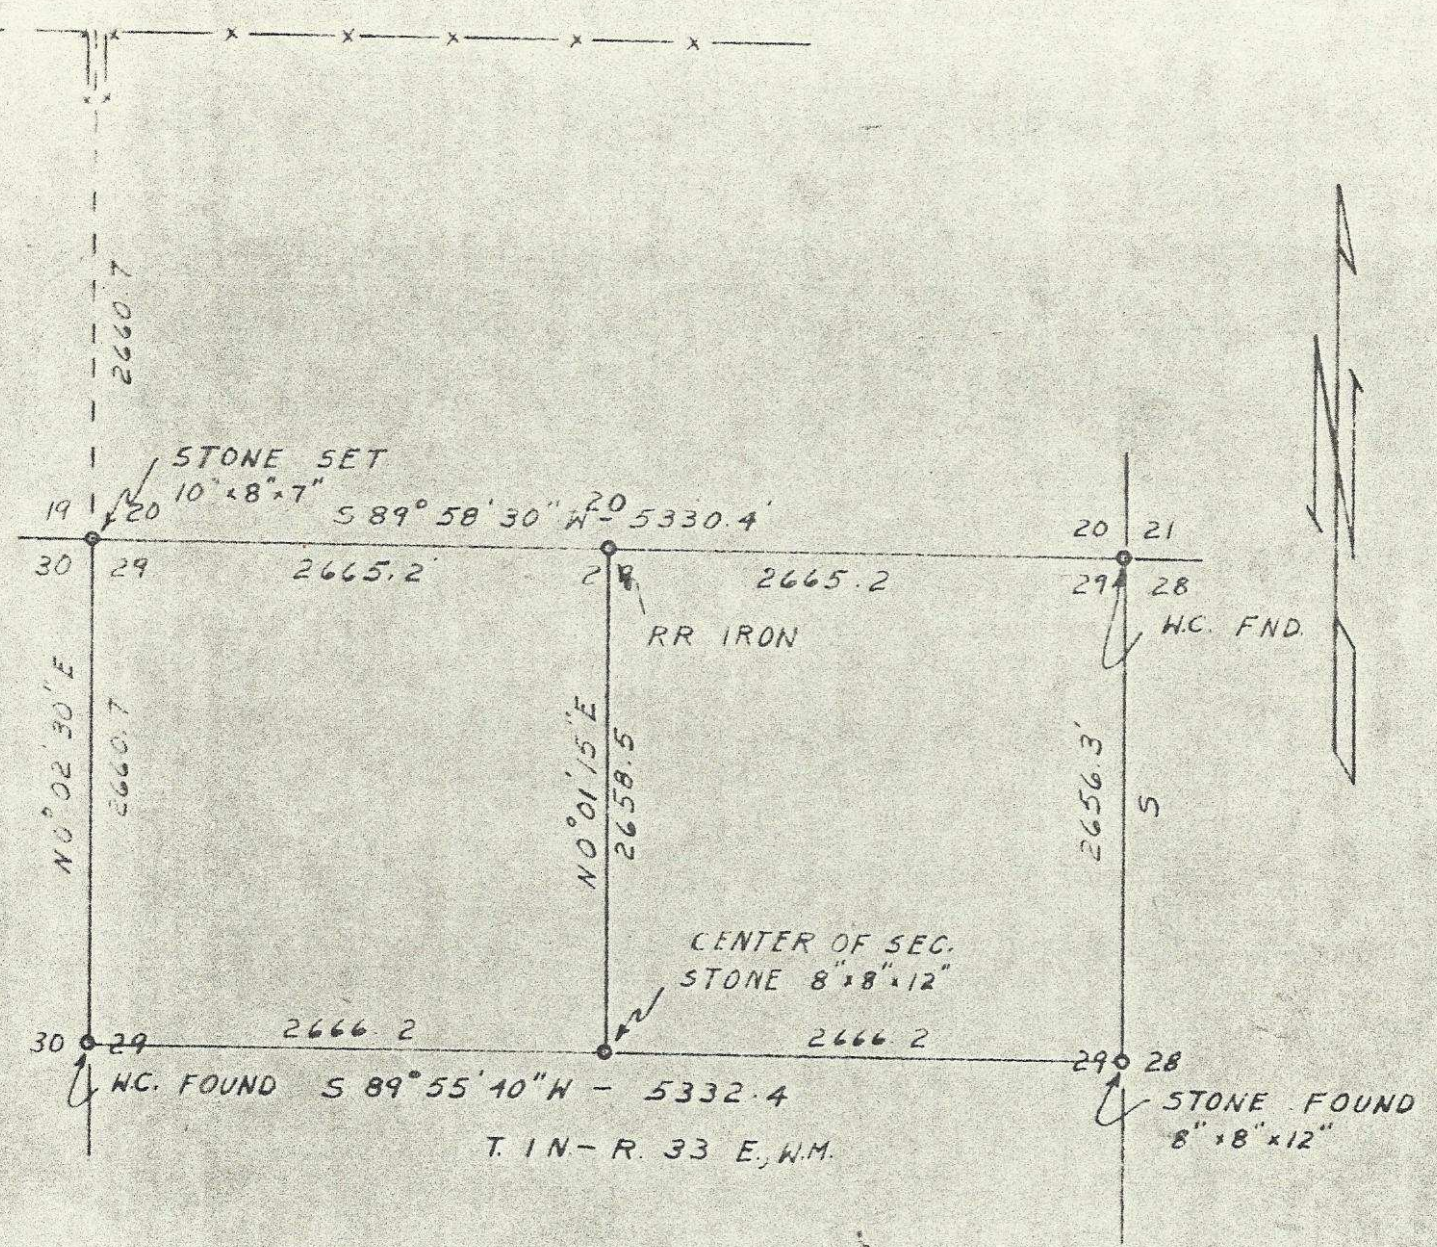

HAYES AND HARRIS			
Survey for			
LOUIS UMBARGER			
NE 1/4 of Sec. 20			
T. 1 N., R. 33 E., W.M.			
Scale	Date	Draw. No.	Draw. By
1"=1000'	7/1/60	60-100	WCH

Q-66-Ax