


Q-83-Ax

PROPERTY SURVEY
for James H. Raley
Date 9-21-53, Dr. by A. French
Scale 1" = 100'

Q-83-Ax

NE SW 1/4

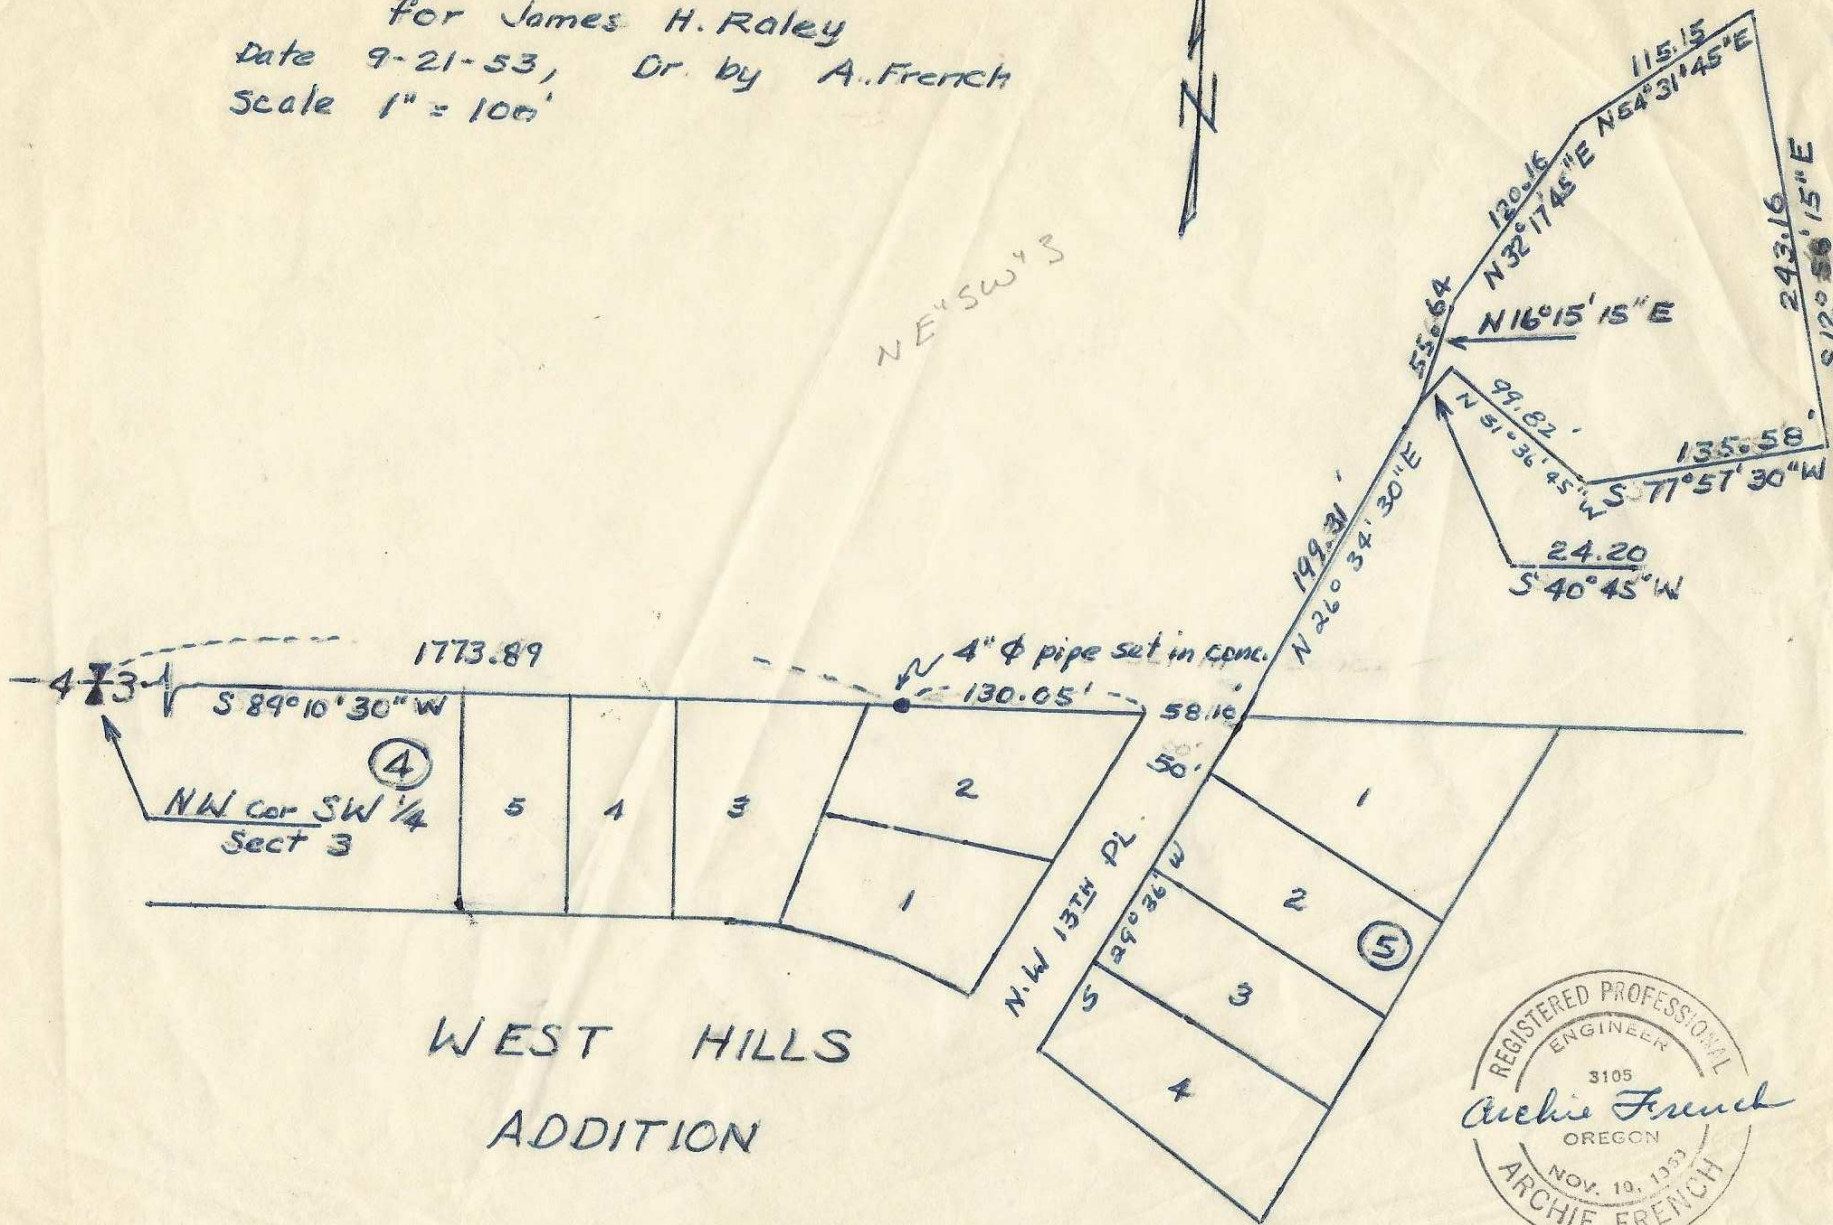

WEST HILLS
ADDITION



Q-83-Ax

872