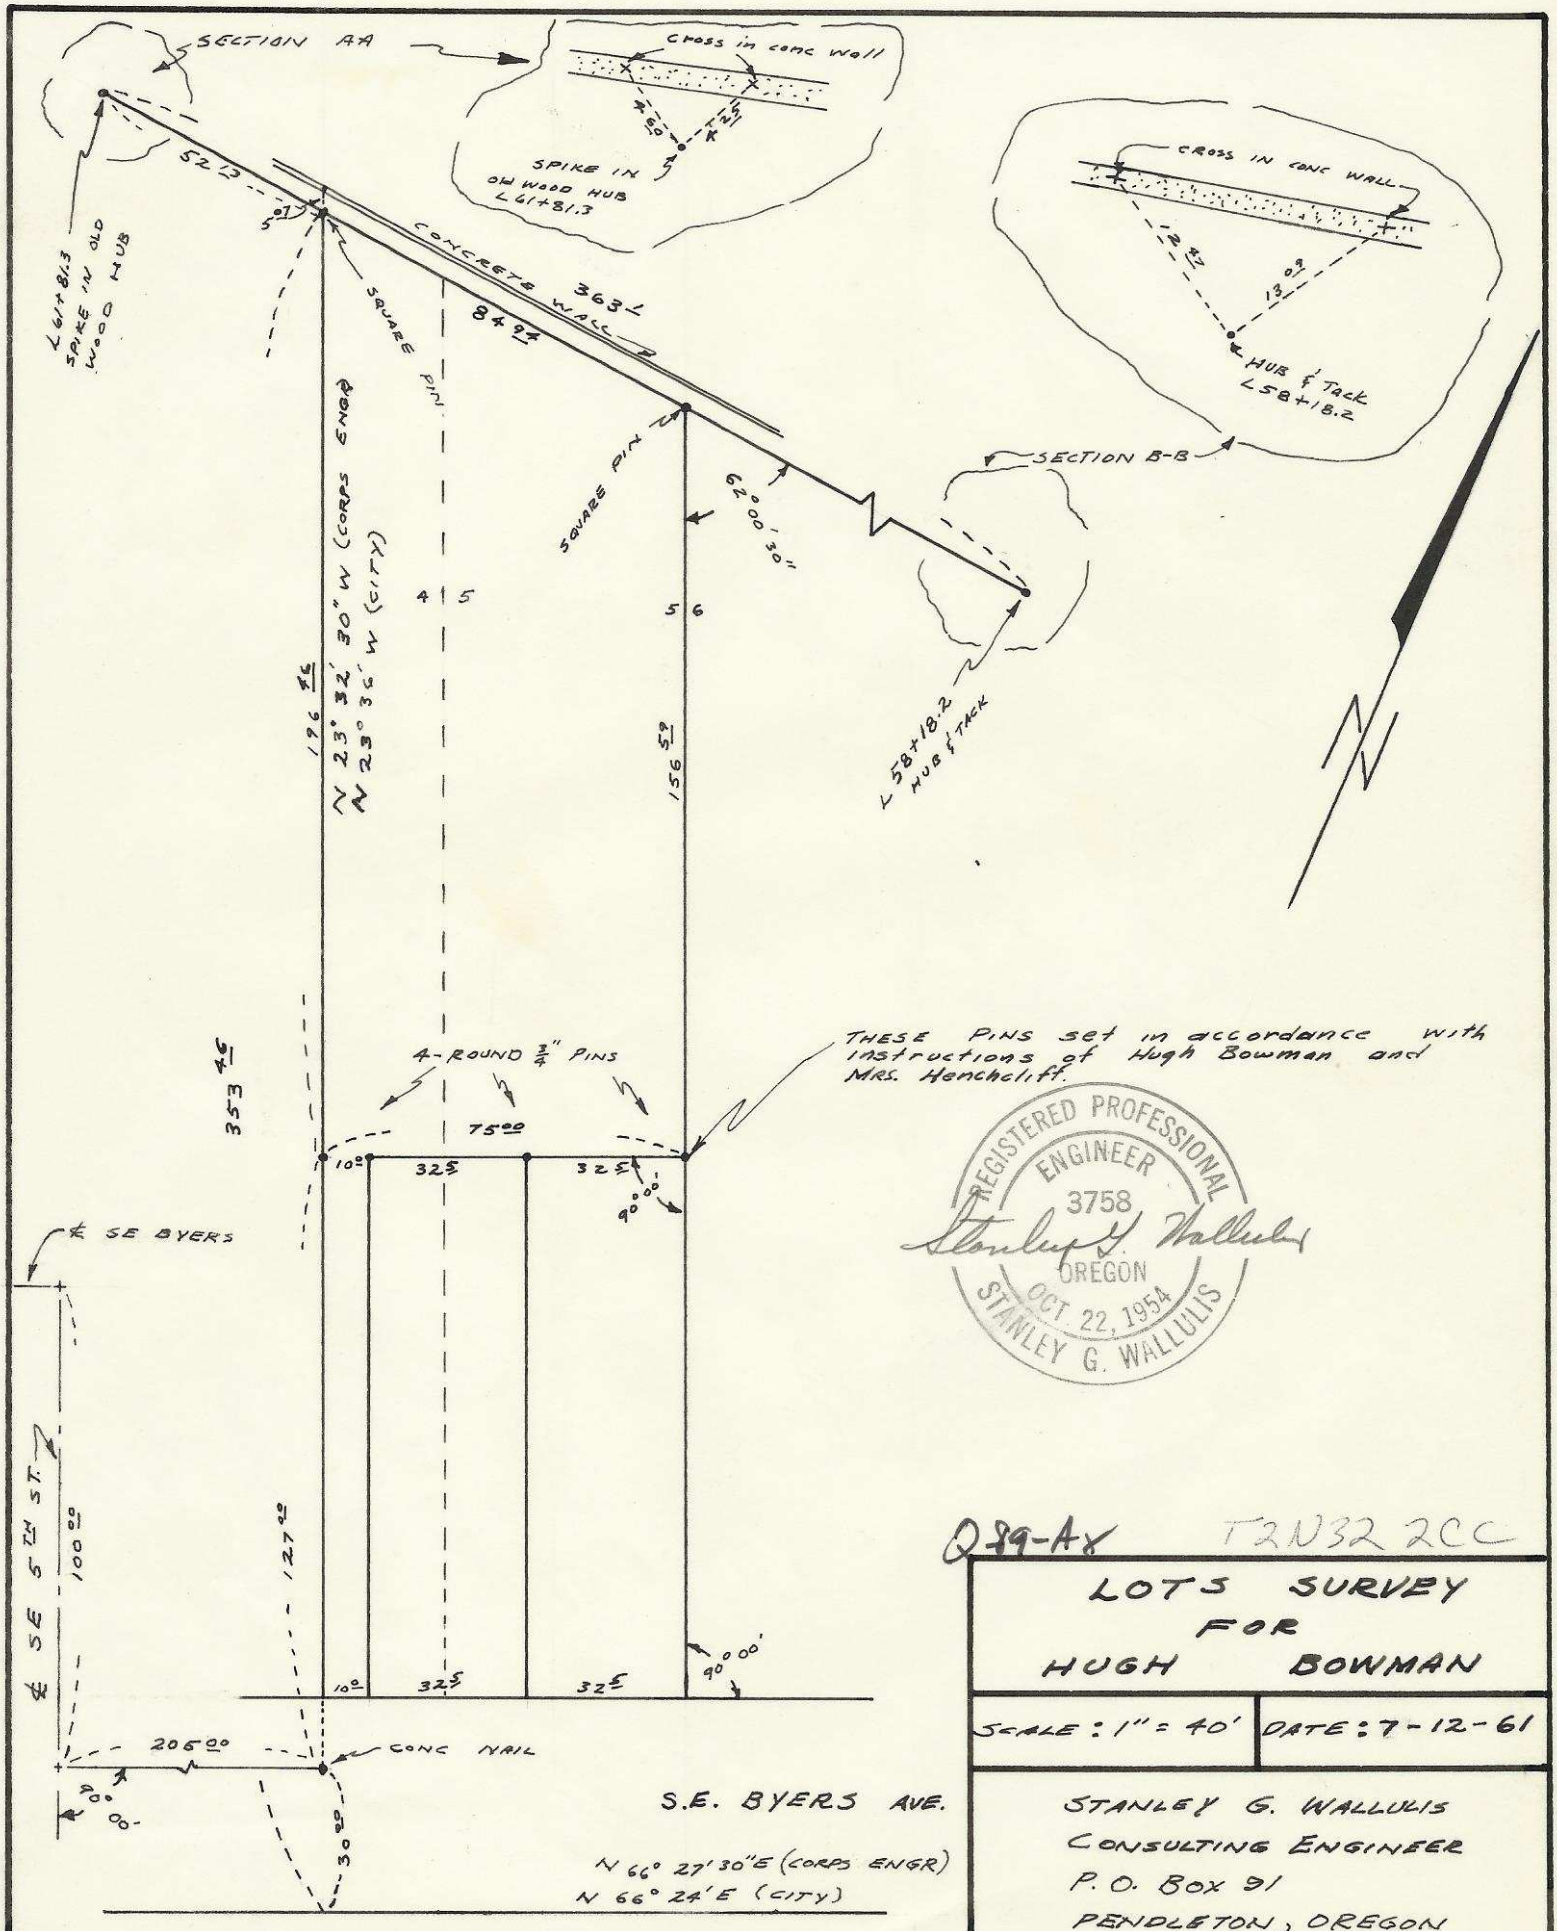

REGISTERED PROFESSIONAL ENGINEER 3758 Stanley G. Wallulis OREGON OCT 22, 1954 STANLEY G. WALLULIS

Q 89-A x T2N32 2CC

LOTS SURVEY FOR HUGH BOWMAN

SCALE: 1" = 40' | DATE: 7-12-61

STANLEY G. WALLULIS
CONSULTING ENGINEER
P.O. BOX 91
PENDLETON, OREGON