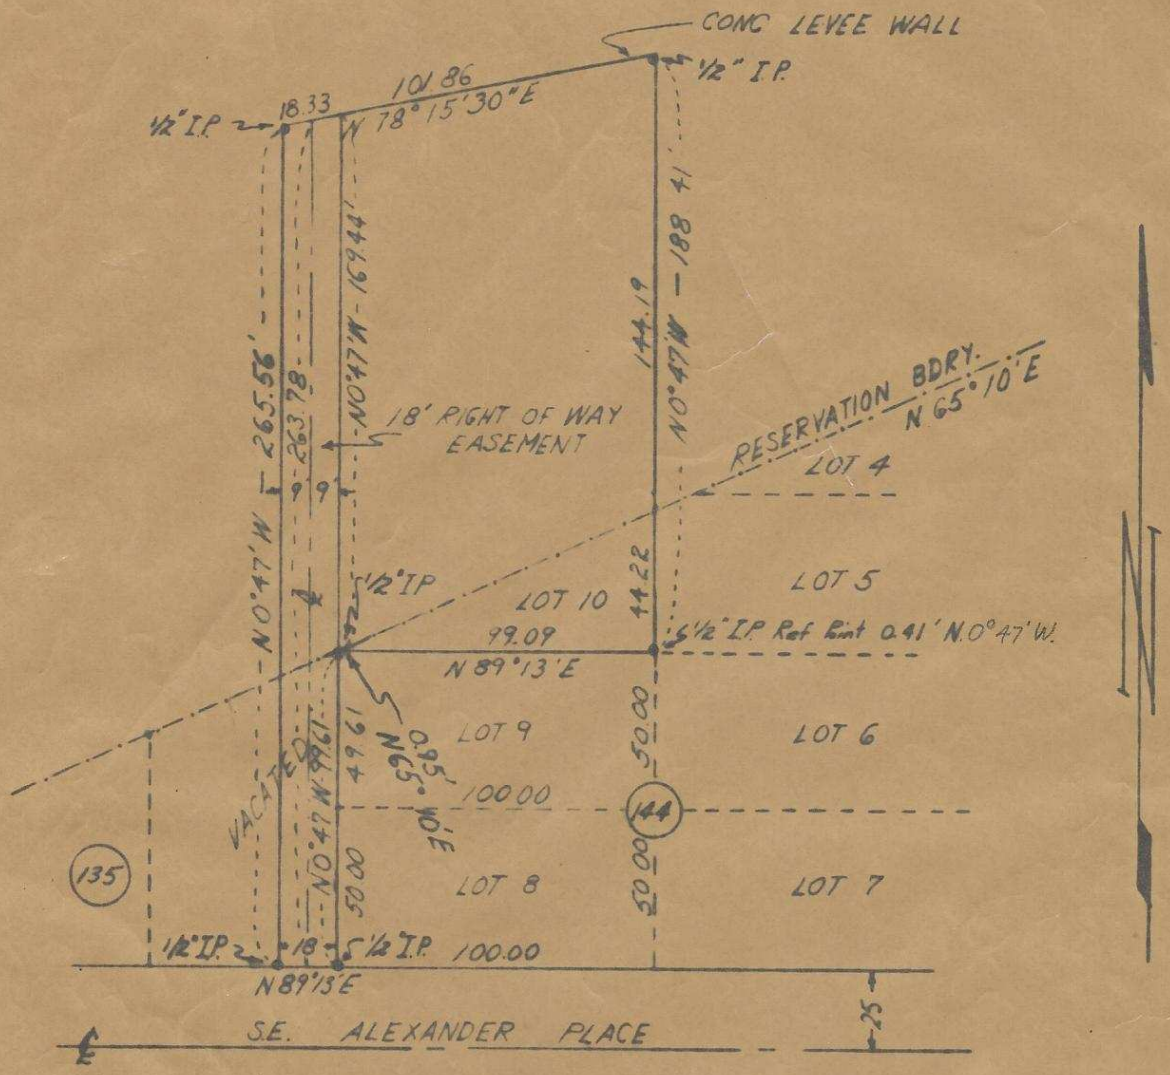

SE ¼ SE ¼ (2)

HAYES AND HARRIS

SURVEY FOR

D. W. DIGGINS

A PARCEL OF LAND IN SEC. 2,
T. 2 N., R. 32 E., W. M.

SCALE	DATE	DRW BY	DRW NO.
1"-60'	4/7/59	RWC	59-86

Wayne O Harris

Q-125-AX

846