Q-134-Ax

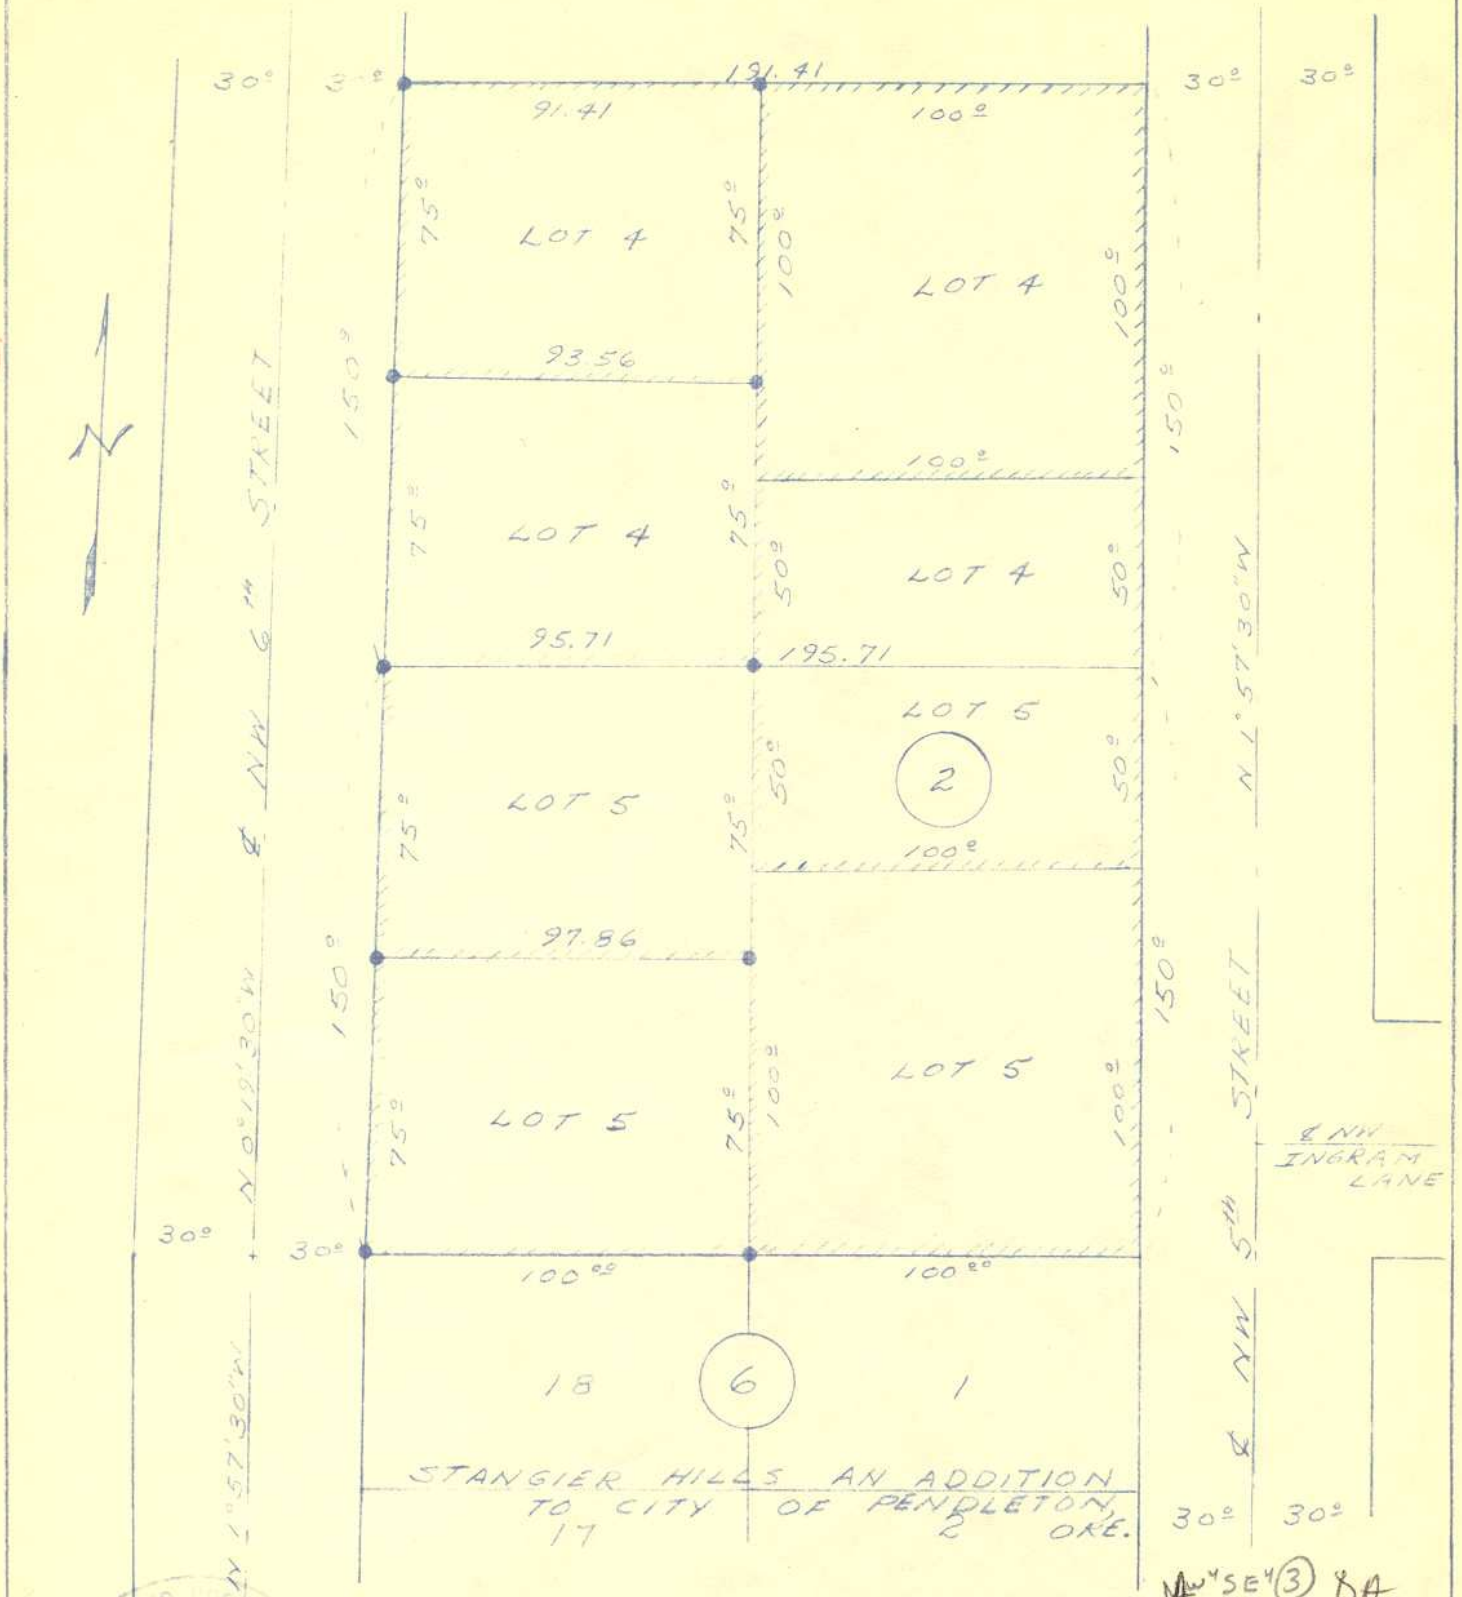

Legend

● --- Pins Set

◉ --- Pins found

NW¼SE¼ ③ 8A

LOT SURVEYS
for
ROBERT STANGIER

Scale 1" = 50'	July 9, 1957

STANLEY G. WALLULIS
Consulting Engineer
Pendleton Oregon

Q-134-Ax 413