


N. W. INGRAM AVE.

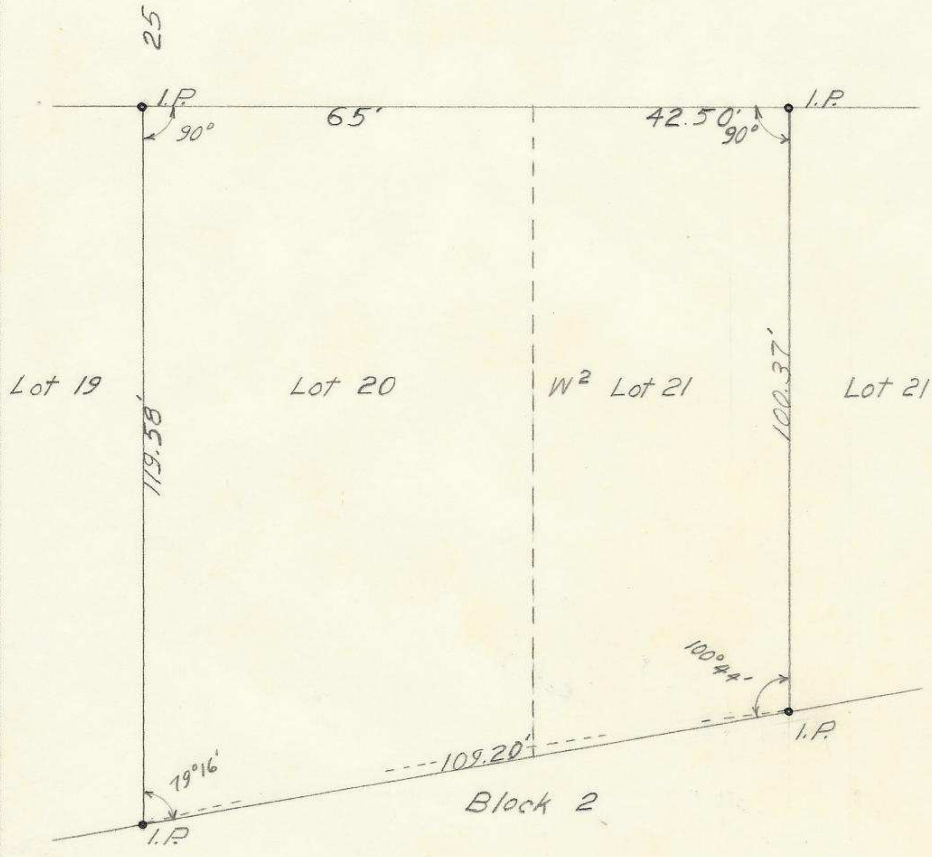

REGISTERED  
**OREGON**  
 LAND SURVEYOR

*Wayne O. Harris*

MAY 6, 1955  
 WAYNE O. HARRIS  
 346

Q-152-Ax

HAYES & HARRIS ENGINEERING

Survey For

PENDLETON HOUSING CORP.

Lot 20 & W.  $\frac{1}{2}$  Lot 21, Block 2

West Hills Add'n, Pendleton, Oregon

Scale	Date	Drn. By	Drng. No.
1" - 30'	4/13/56	W.O.H.	20

T2N R32 3CA