


Q-154-A1

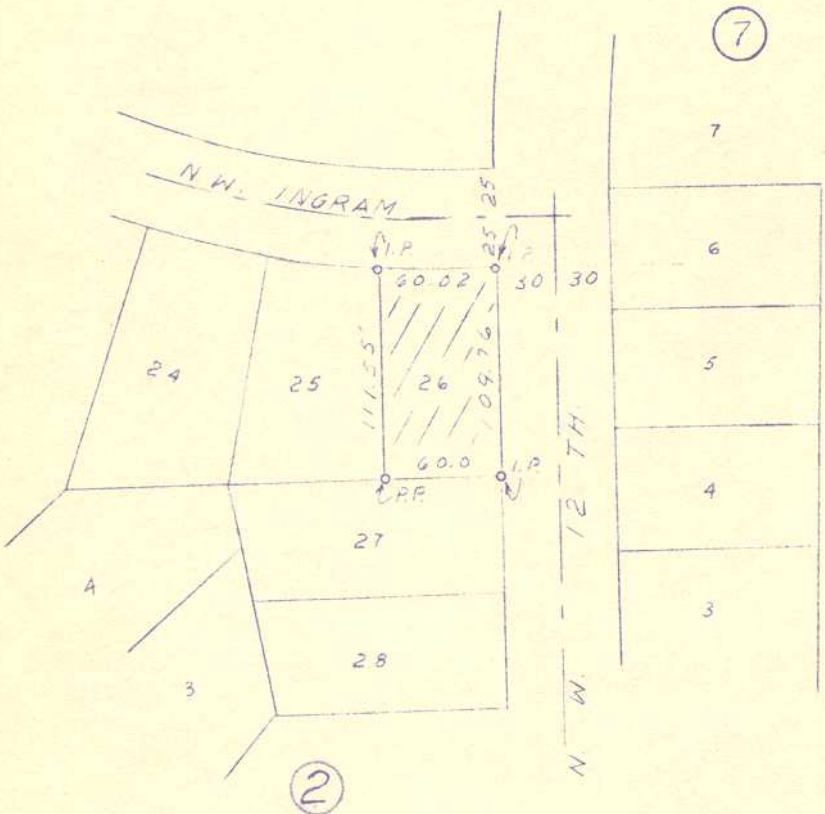

N6°5W (3)

1904 LEGISLATION
 OREGON
 LAND RECEIVED
Wayne C Harris
 WAYNE C. HARRIS
 346

HAYES AND HARRIS			
Survey For			
PENDLETON HOUSING CORP.			
Lot 26	Block 2		
West Hills Addition Pendleton, Oregon			
Scale	Date	Drawn By	Drawn No.
1"-100'	2/4/59	WOH	59-11

Q-154-A1 408