Q-180-Ax

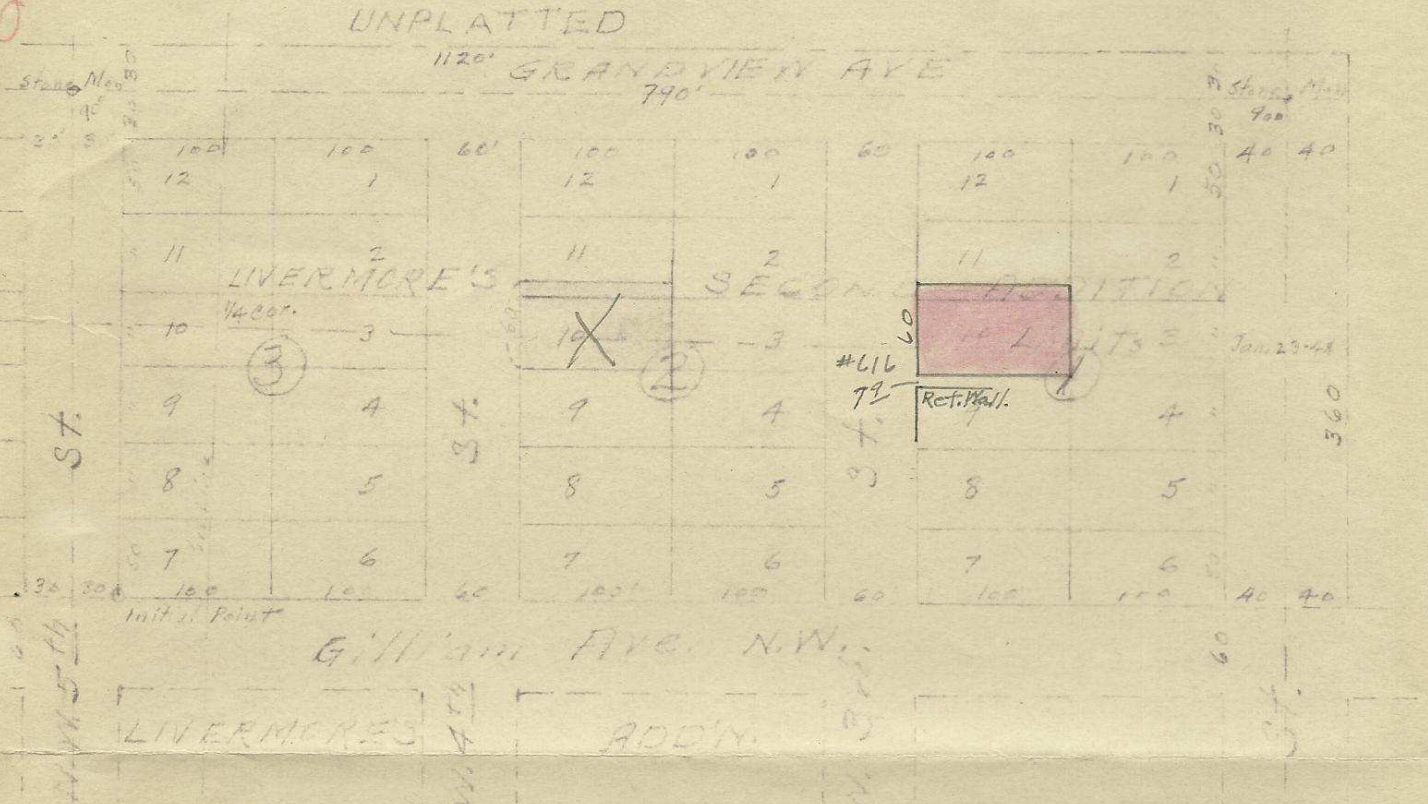

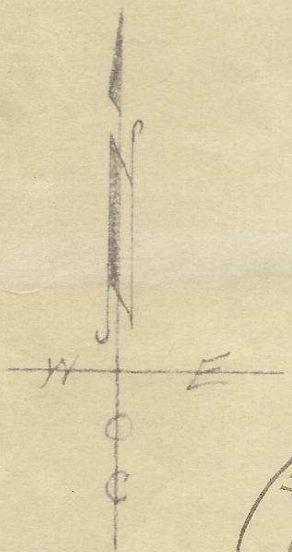

Plat Showing
Part of Livermores Second Addition
To the Town, now City of Pendleton, Oregon
Scale: 1 inch = 150 feet.

SE¼SE¼ (3)

W. E. O. CRIGER
MAR. 9, 1931
OREGON
REGISTERED PROFESSIONAL ENGINEER
1497

Q-180-Ax