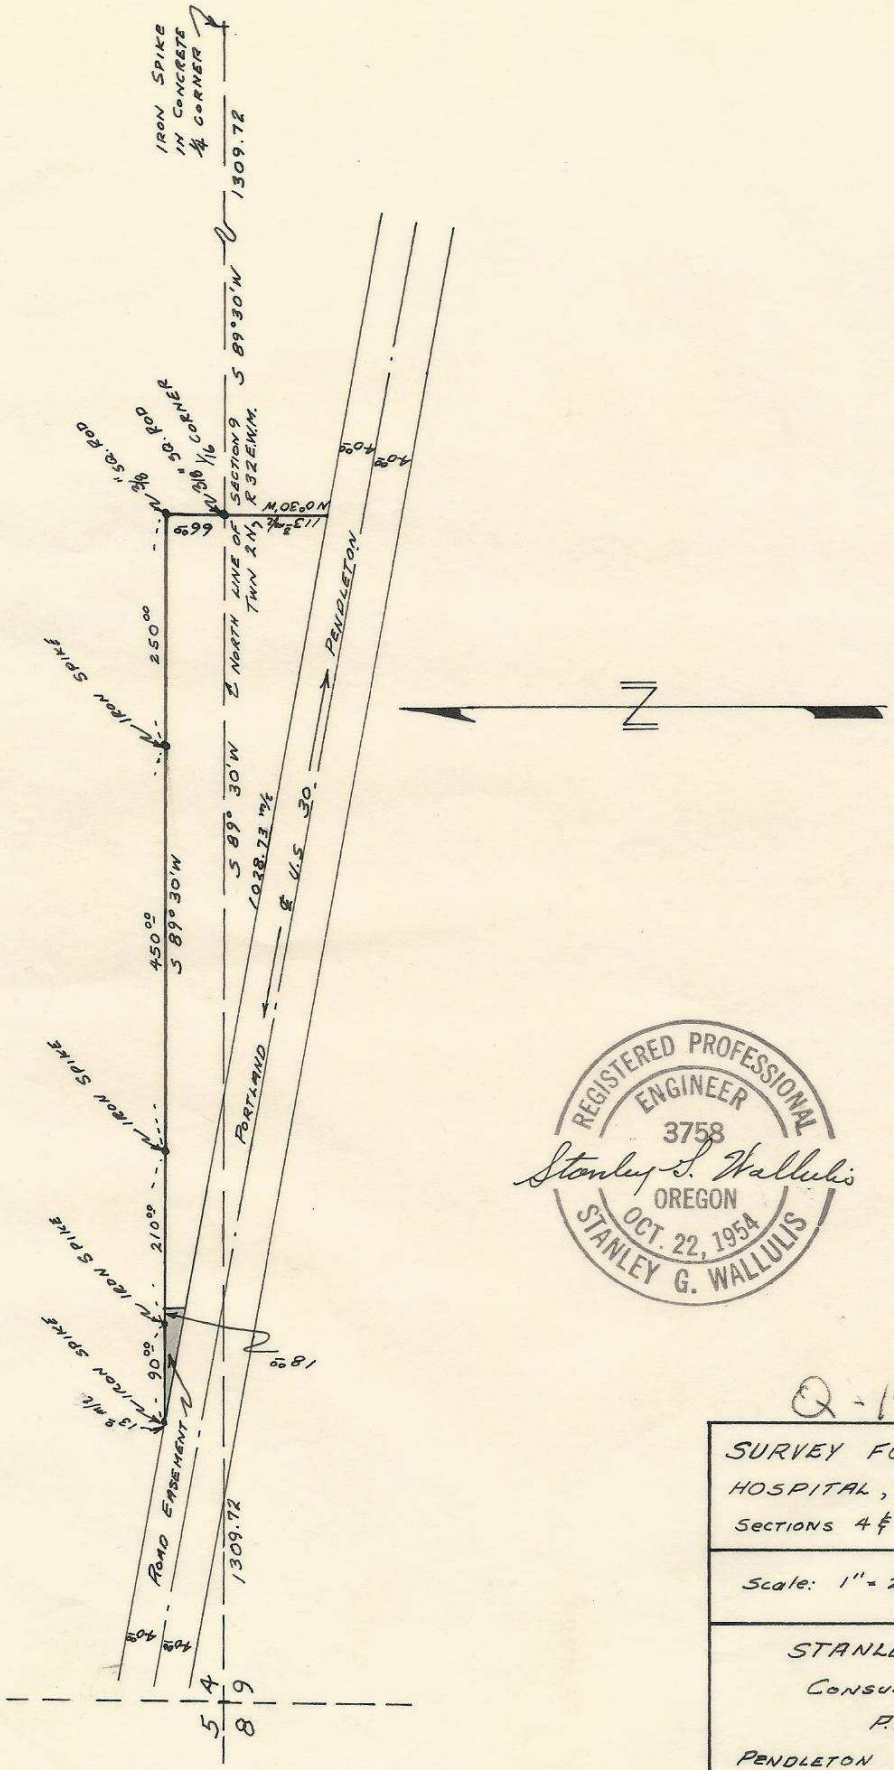

REGISTERED PROFESSIONAL ENGINEER
3758
Stanley G. Wallulis
OREGON
OCT. 22, 1954
STANLEY G. WALLULIS

Q-199-Ax

SURVEY FOR OREGON STATE HOSPITAL, PENDLETON, OREGON
Sections 4 & 9, Twn 2 N, R 32 E W M

Scale: 1" = 200' | Date: MAY 16, 1960

STANLEY G. WALLULIS
CONSULTING ENGINEER
P.O. Box 91
PENDLETON OREGON

SW (2)