
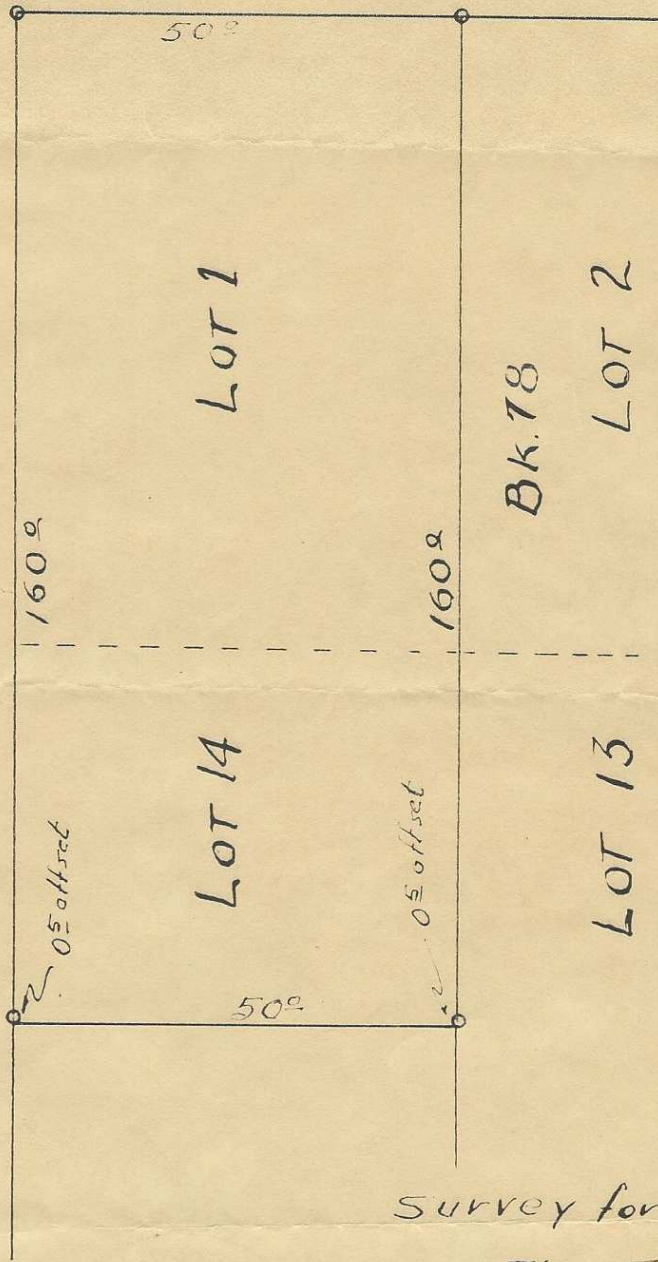


S.M. Emigrant

S.W 5<sup>th</sup>

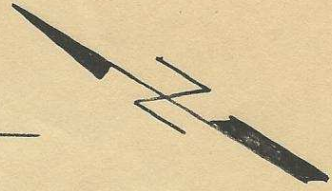

Bk. 78

Reservation Addn.

Survey for  
Thye Fendors

2N3210AD

SCALE: 1" = 30 ft

DATE: 4-8-57

WALL AND TENNESON  
Engineers

The Dalles Pendleton

Oregon

Q-258-Ax