Q-300-AX

orig

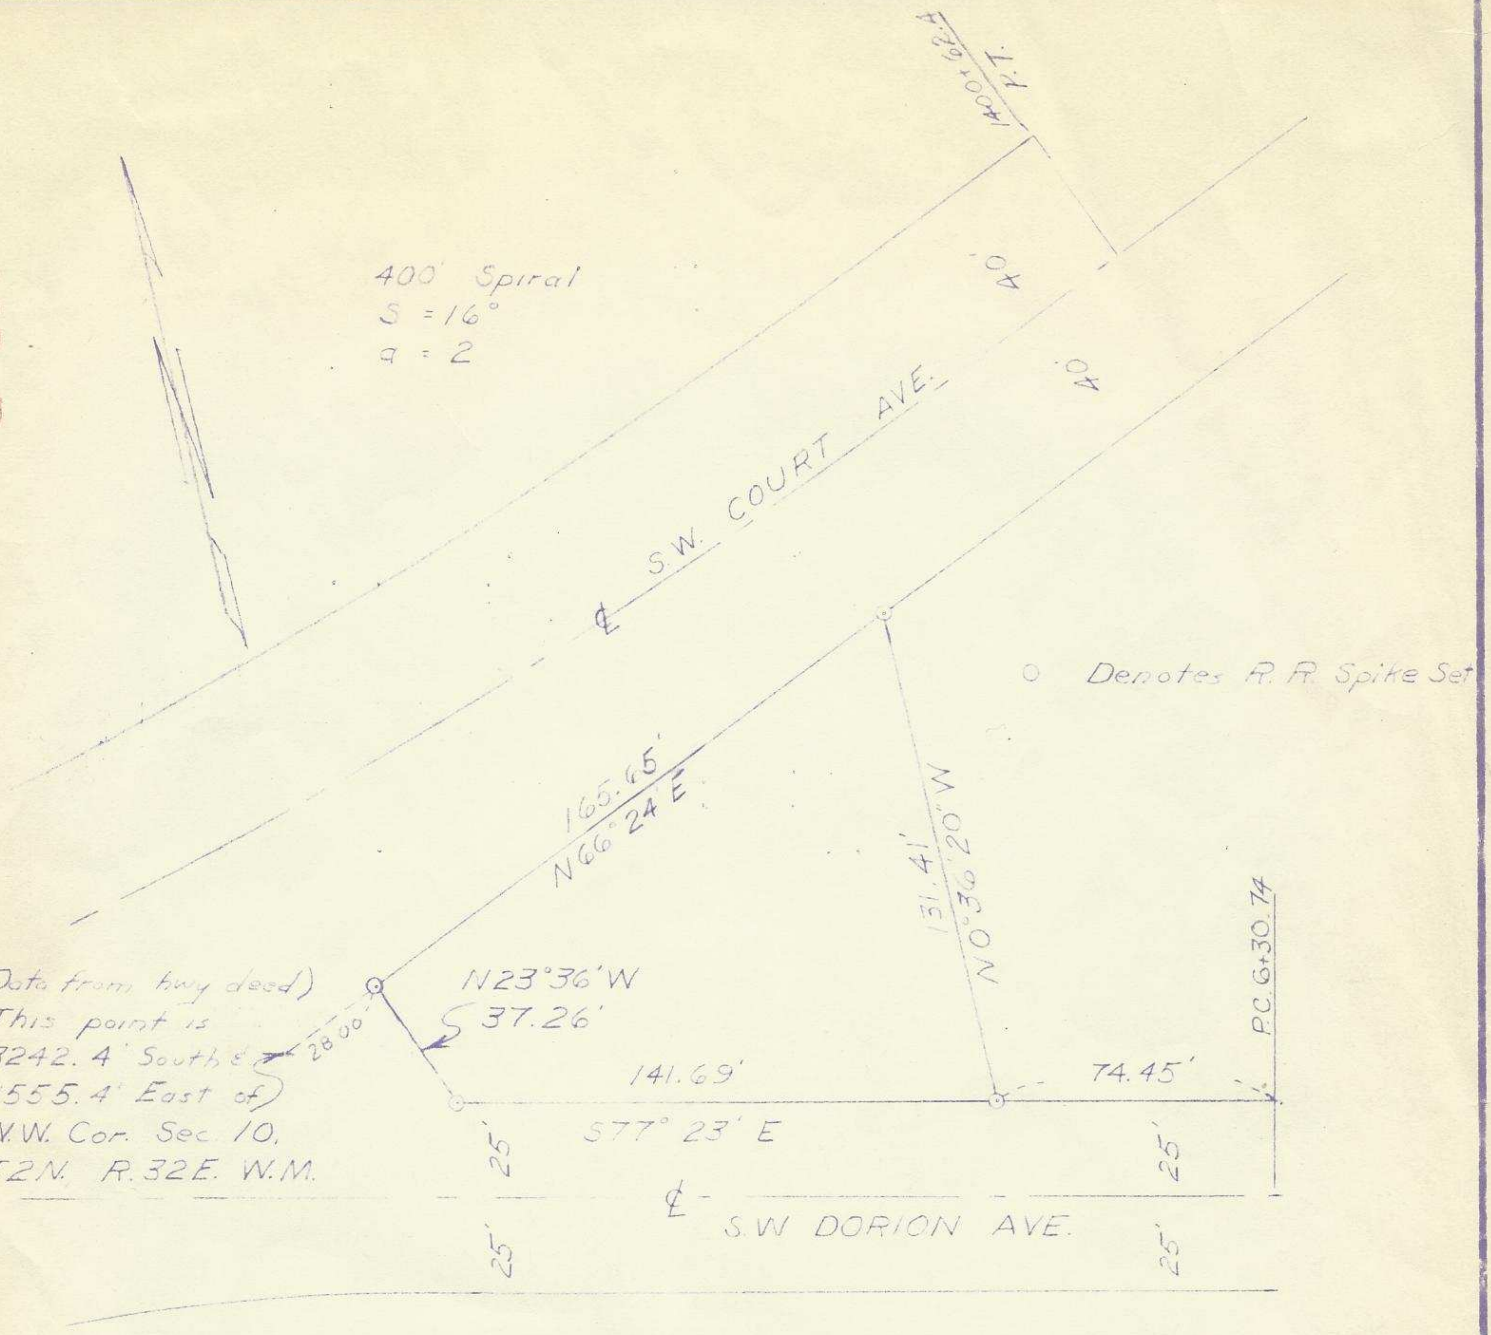

SE¼ NW¼ (10)

REGISTERED OREGON LAND SURVEYOR
Wayne O. Harris
WAYNE O. HARRIS
346

HAYES AND HARRIS

SURVEY FOR

RAY MITCHELL

Q-300-AX

PARCEL IN SECTION 10,
T. 2 N., R. 32 E., W.M.

SCALE	DATE	DRN. BY	DRNG. NO.
1"=50'	15 JAN 62	L.H.A.	62 - 161