BY ..... DATE ..... SUBJECT ..... SHEET NO. ..... OF .....

CHKD. BY ..... DATE ..... JOB NO. .....

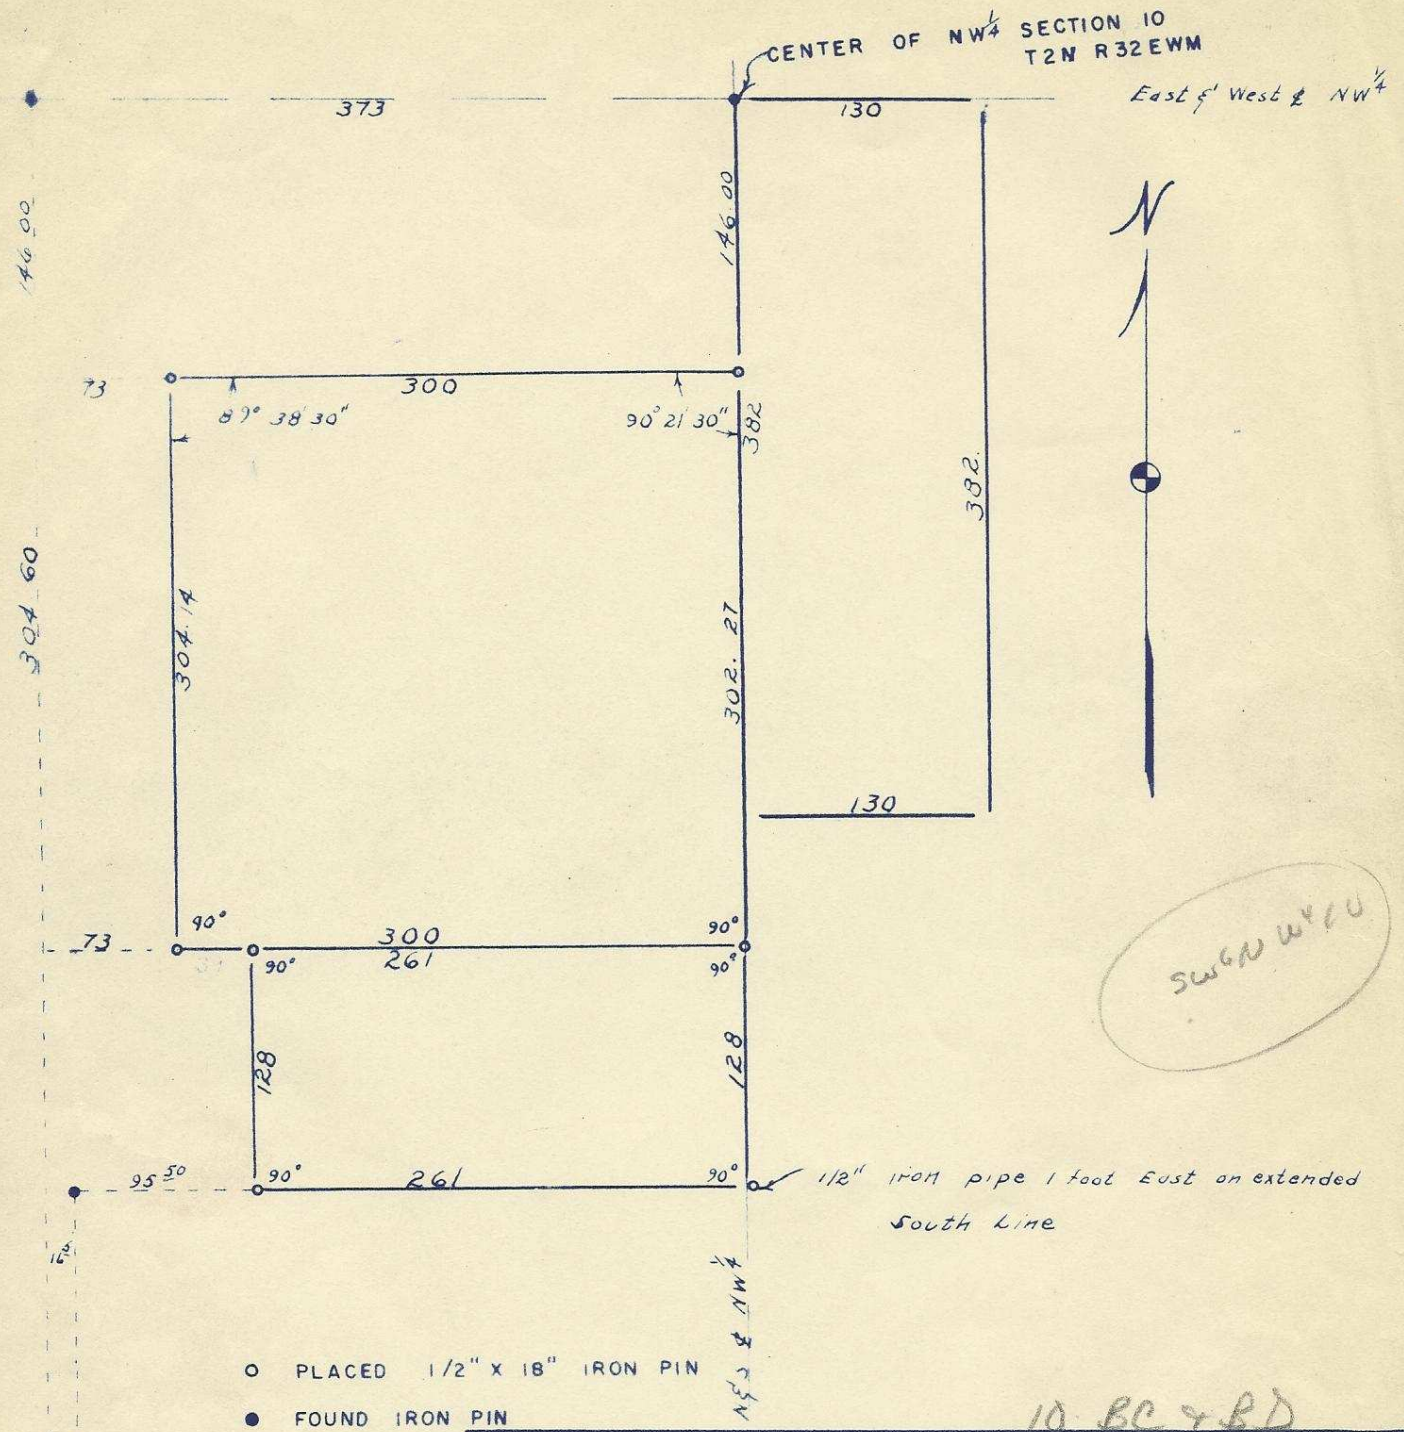

THE CITY OF PENDLETON

OFFICE OF THE CITY ENGINEER

ARMORY LAND

Q-319-Ax

DR BY: Charles Eddleman CK. BY: A. French	IMPROVEMENT DIST. NO.	
SCALE: 1" = 100'	DATE: 1-28-55	DRG. NO.: A-55-2-M

Q-319-Ax

815