


OR 19
Q-581-AX

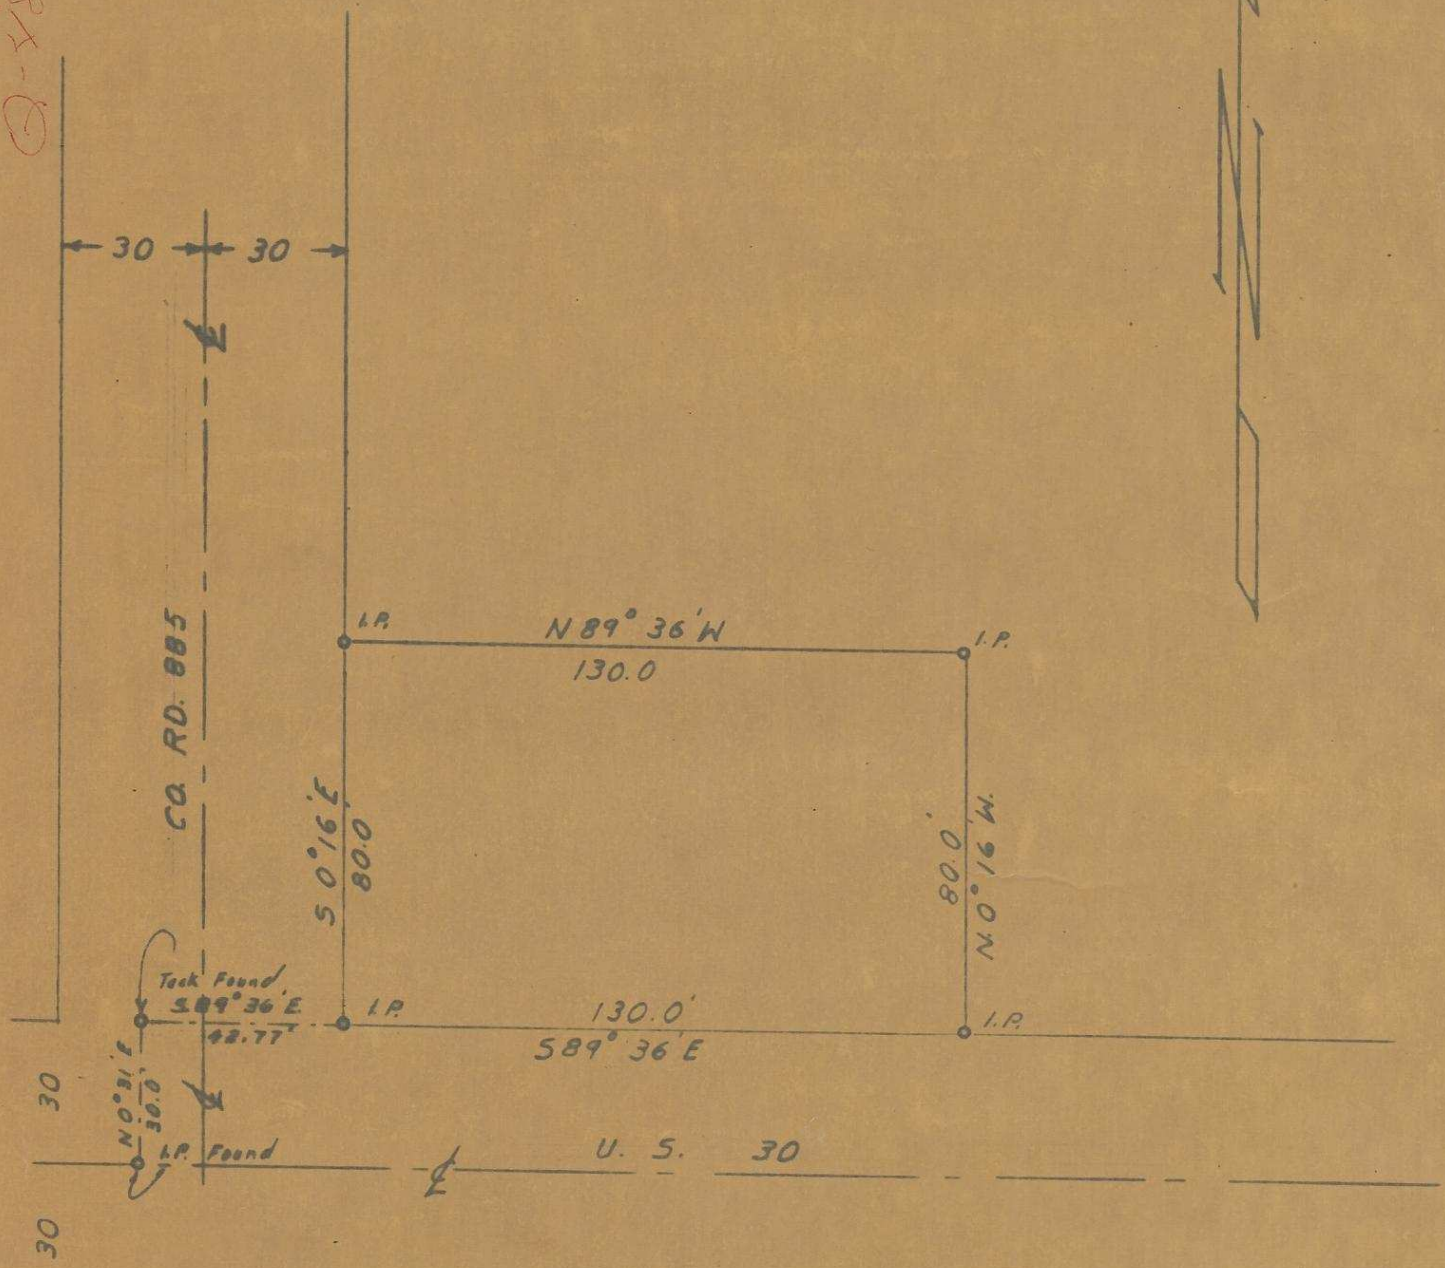

REGISTERED
OREGON
 LAND SURVEYOR
Wayne O. Harris
 MAY 6, 1954
 WAYNE O. HARRIS
 346

HAYES AND HARRIS

Survey For

R. P. GRAVES

Parcel In Sec. 10
 T. 2 N.-R. 33 E., W.M.

| Scale | Date | Drn. by | Drng. No. |
|--------|---------|---------|-----------|
| 1"-40' | 11/5/58 | WOH | 58-73 |