



MISSION TRACTS

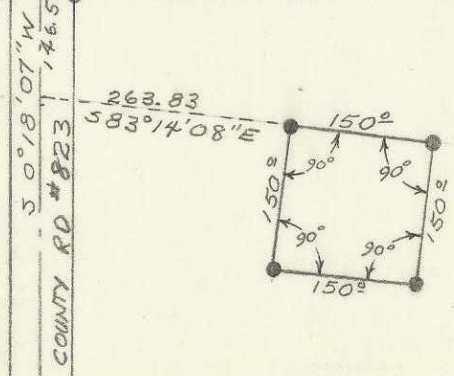

LEGEND
 ○ - - - - PINS FOUND
 ● - - - - PINS SET

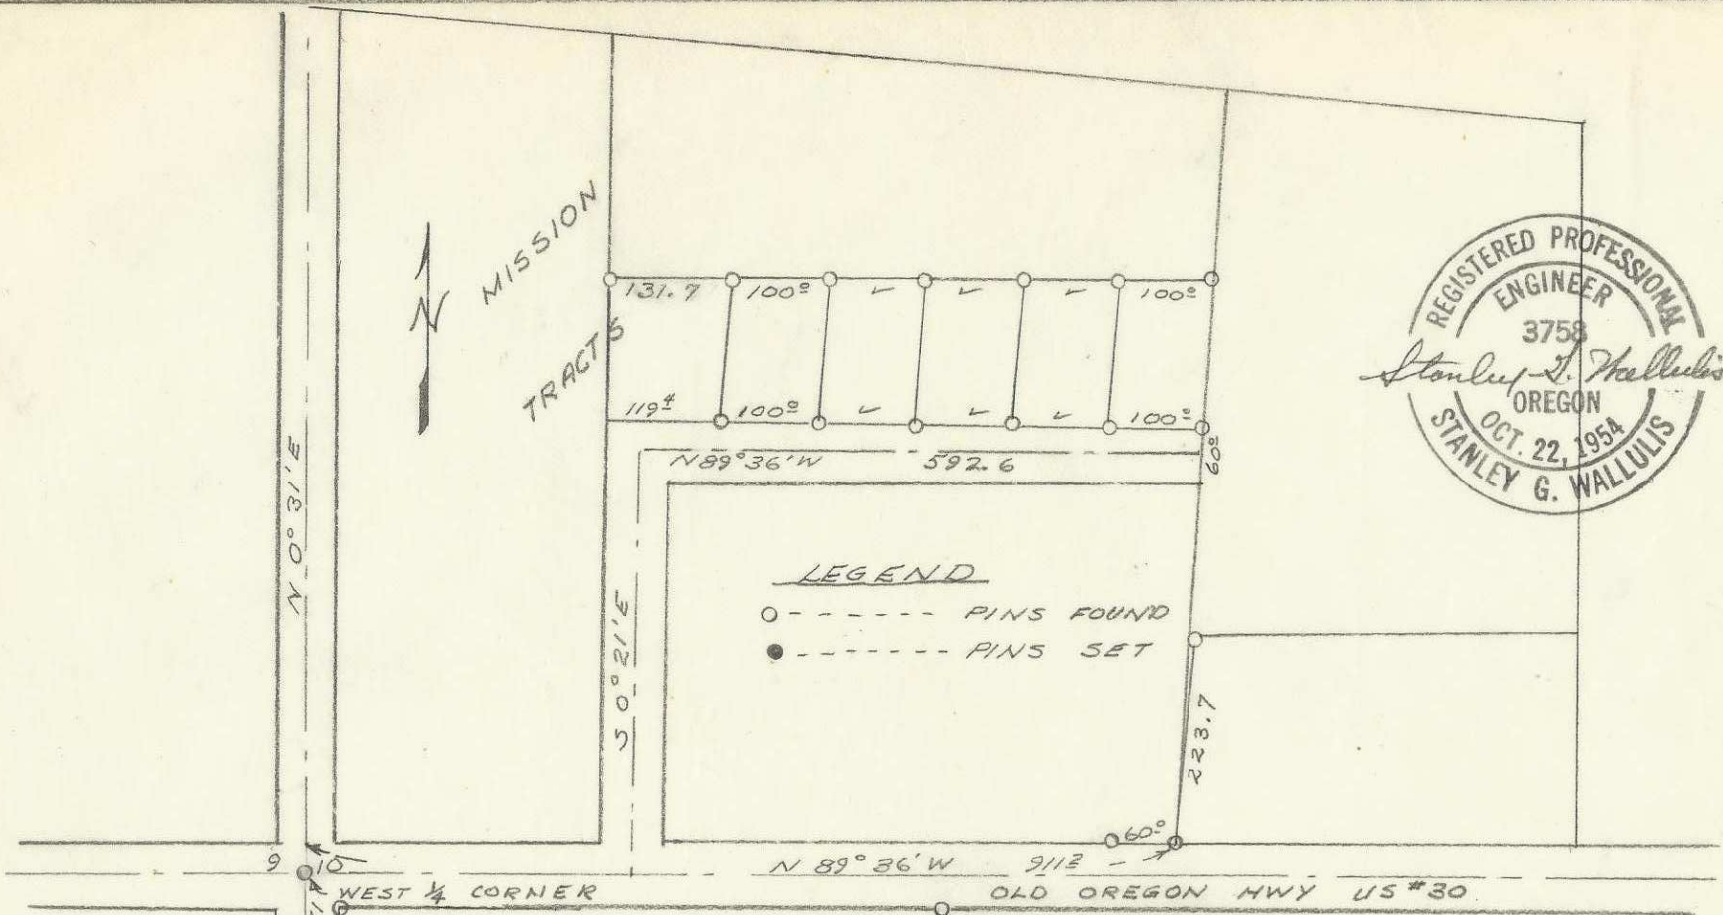

Q-502-Ax

SURVEY FOR GILBERT CONNER SEC 10, TWN 2N, R 33E.W.M.	
Scale 1" = 200'	MAY 19, 1958
STANLEY G. WALLULIS Consulting Engineer PENDLETON OREGON	