



Q-877-AX

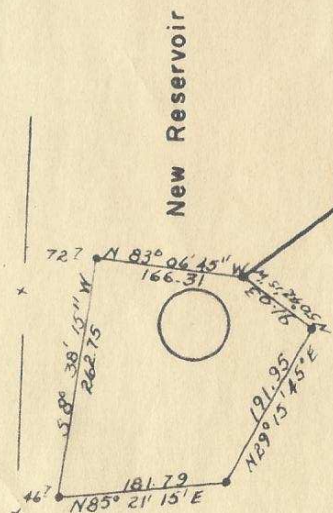

New Reservoir

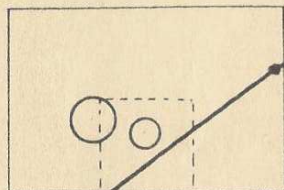

25 Foot Wide Easement

LEGEND

• 1/2" X 24" Steel Rod

S 55° 23' 45" W
676.77

S 48° 00' W
487.60

WE 17

WEST
20.00

S 28° 18' E
132.00

WILLOW ST.
400.00

PILOT ROCK

CITY OF

MAIN ST.
NORTH

Monument



527

SCALE: 1" = 200'

DATE: 5-14-56

WALL AND TENNESON

Engineers

The Dalles

Oregon