


Q-928-Ax

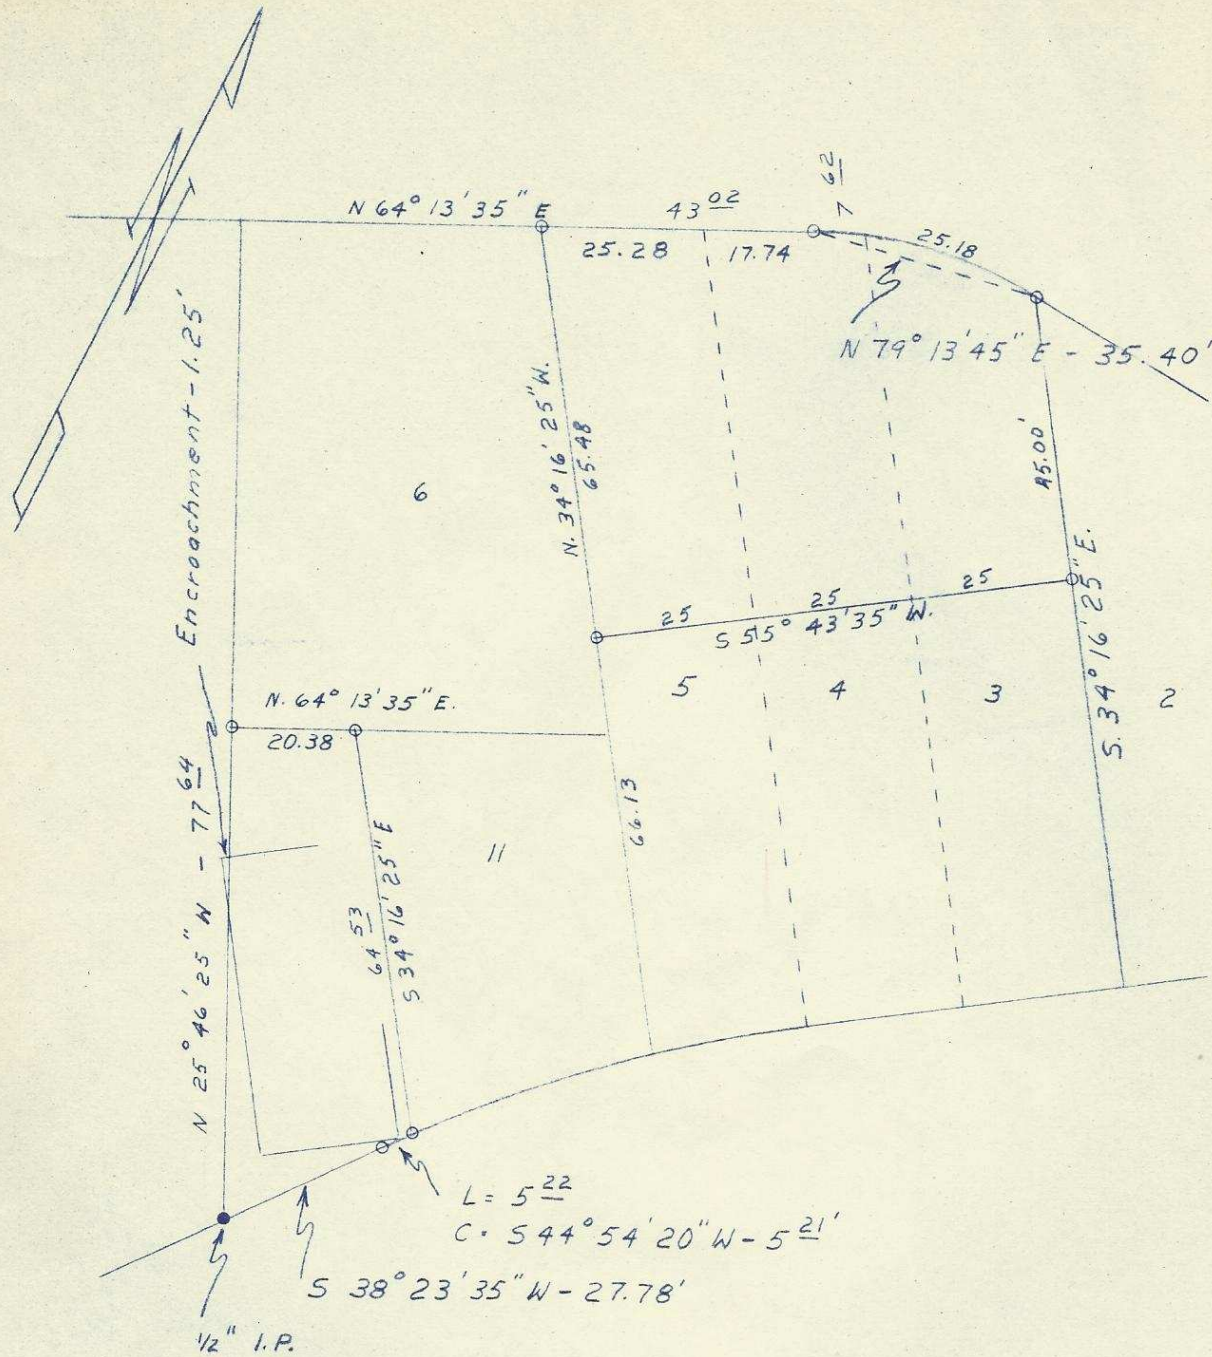

RECORDED
 OREGON
 LAND COMMISSION

Wayne O. Harris

WAYNE O. HARRIS
 346

HAYES AND HARRIS				
Survey For HARRY ROOP				
Lot 11		Block 4		
Doris, Oregon				
Scale	Date	Drn.	By	Drng. No.
1"-30'	12-7-60	WOH		60-142

ORD 9