


Q-976-AX

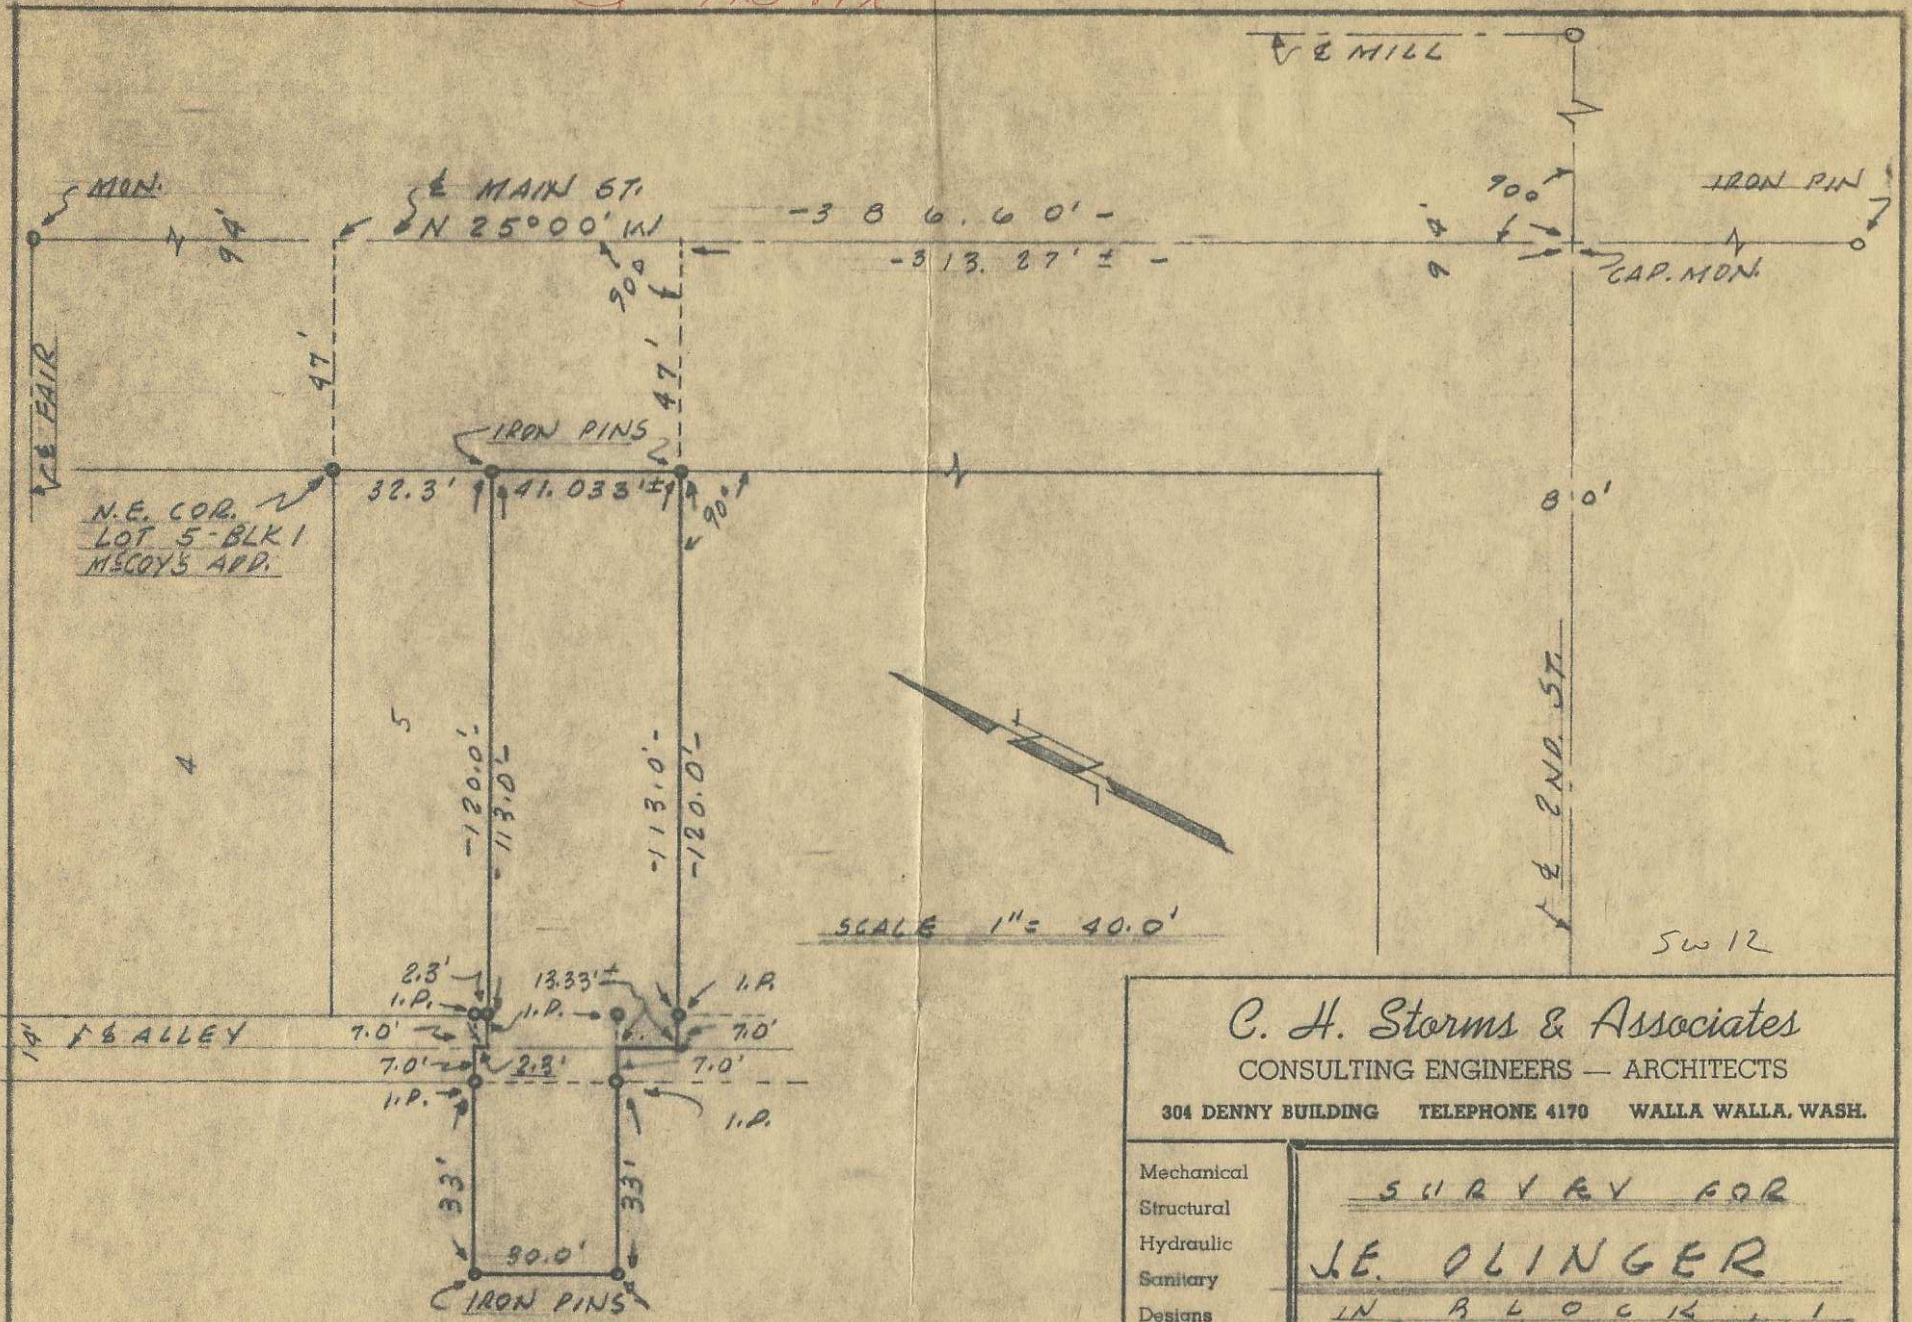

SCALE 1" = 40.0'

C. H. Storms & Associates

CONSULTING ENGINEERS — ARCHITECTS

304 DENNY BUILDING TELEPHONE 4170 WALLA WALLA, WASH.

- Mechanical
- Structural
- Hydraulic
- Sanitary
- Designs
- Land Surveys
- House Plans
- Blue Prints
- Estimates

SURVEY FOR
J. E. OLINGER
 IN BLOCK 12
 MSCOY'S ADDN.
 WILSON, OREGON

Date 5-25-49
 Drawn By J.O.B.
 Checked By RNB

B6B
 SHEET 1 OF 1

Filed May 27-49