
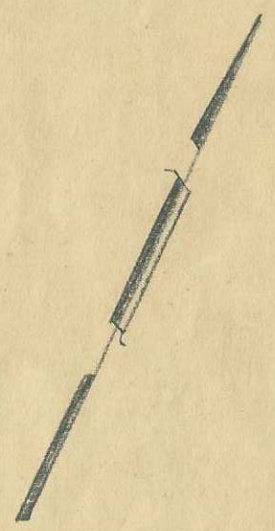


Q-999-AX

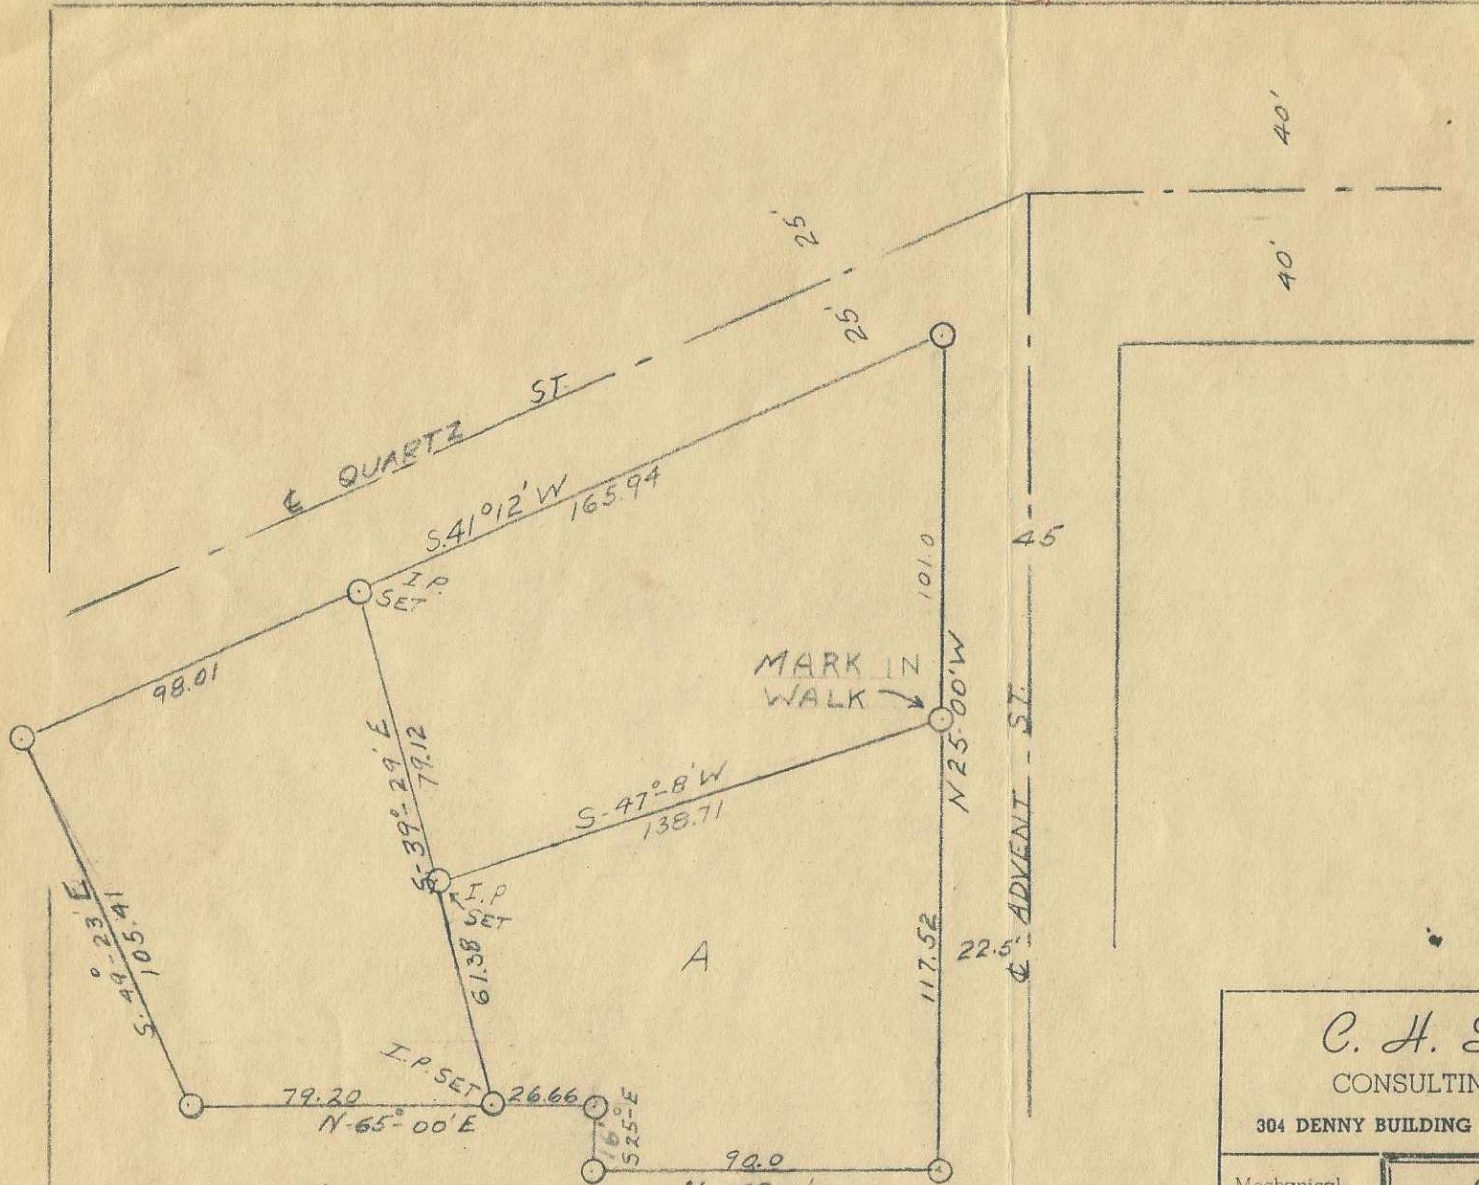

BD

NW 12

C. H. Storms & Associates

CONSULTING ENGINEERS — ARCHITECTS

304 DENNY BUILDING TELEPHONE 4170 WALLA WALLA, WASH.

- Mechanical
- Structural
- Hydraulic
- Sanitary
- Designs
- Land Surveys
- House Plans
- Blue Prints
- Estimates

A SURVEY FOR
 GUY WRINKLE.
 MILTON, OREGON.

Date May 28 49
 Drawn By G.L.
 Checked By G.M.V.

814
 SHEET 1 OF 1

NOTE - 5/8" IRON RODS SET
 AT ALL CORNERS.

SCALE 1" = 50.0'

Filed 4/13/49.

1036