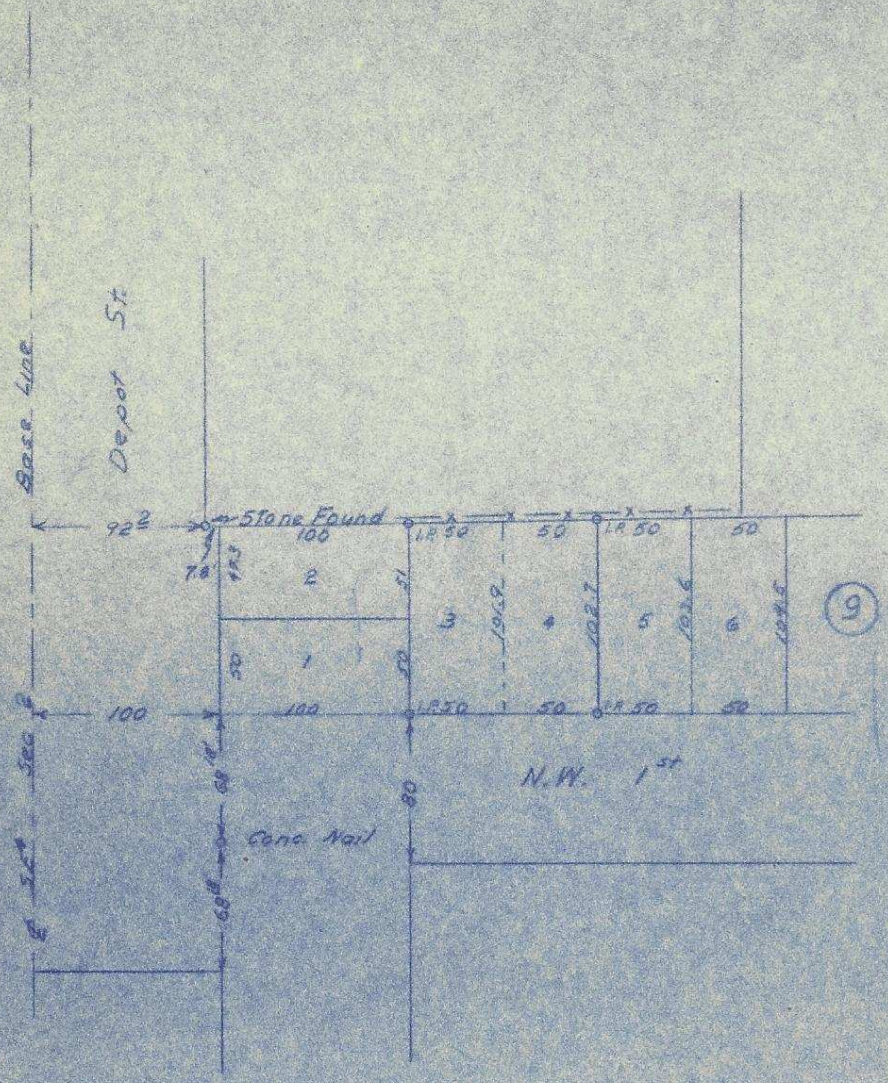

Q-1005-A+

5N352DA

5E(2)

REGISTERED
OREGON
LAND SURVEYOR

Wayne O Harris

MAY 6, 1986
WAYNE O. HARRIS
346

HAYES AND HARRIS ENGINEERING

Survey For

ROY GRIMES

Lots 3 & 4, Blk. 9, N. Milton Add'n., Milton-Freewater, Ore.

Scale	Date	Drn. By	Drwg. No.
1"= 100'	11/16/86	W.O.H.	

101