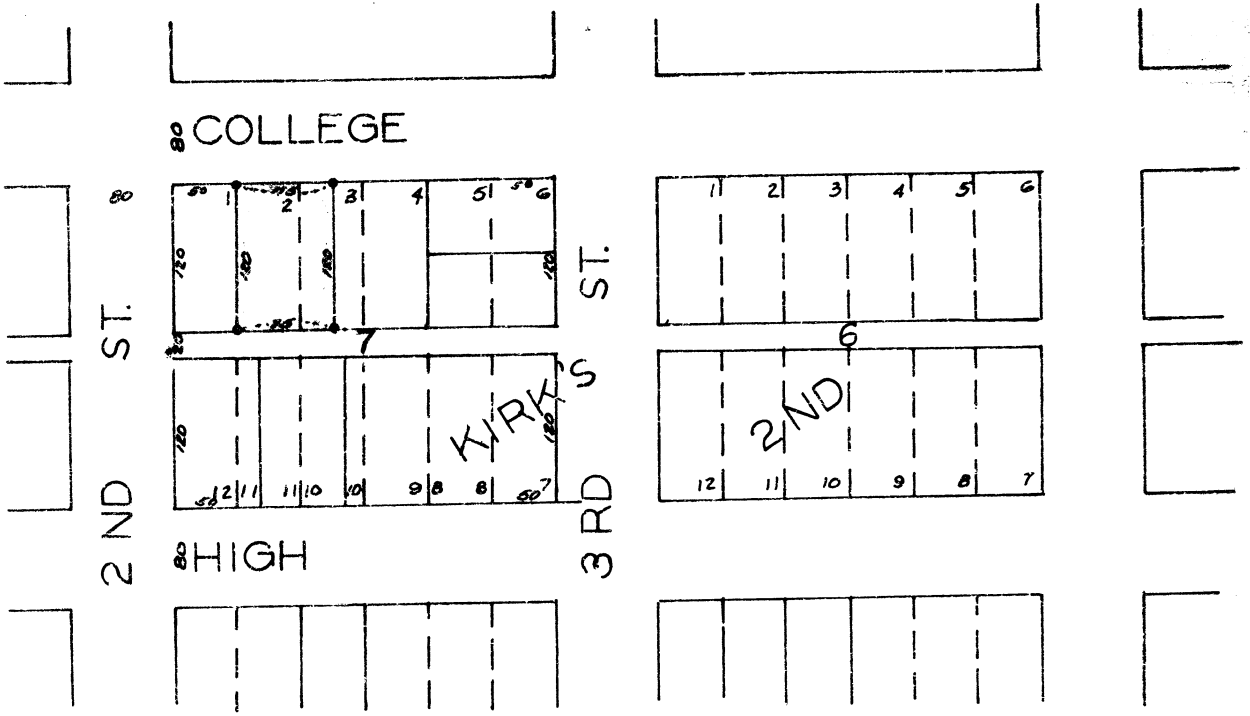


REGISTERED
OREGON
LAND SURVEYOR
Ralph P. Thompson
MAY 13, 1960
RALPH P. THOMPSON
506

Property Survey For
ARTHUR DAY
In ATHENA, ORE
Date: 5-4-64 | Scale: 1"=100'

**R. P. THOMPSON**
REGISTERED PROFESSIONAL LAND SURVEYOR
13 S. E. COURT AVE. PENDLETON, OREGON

A-6
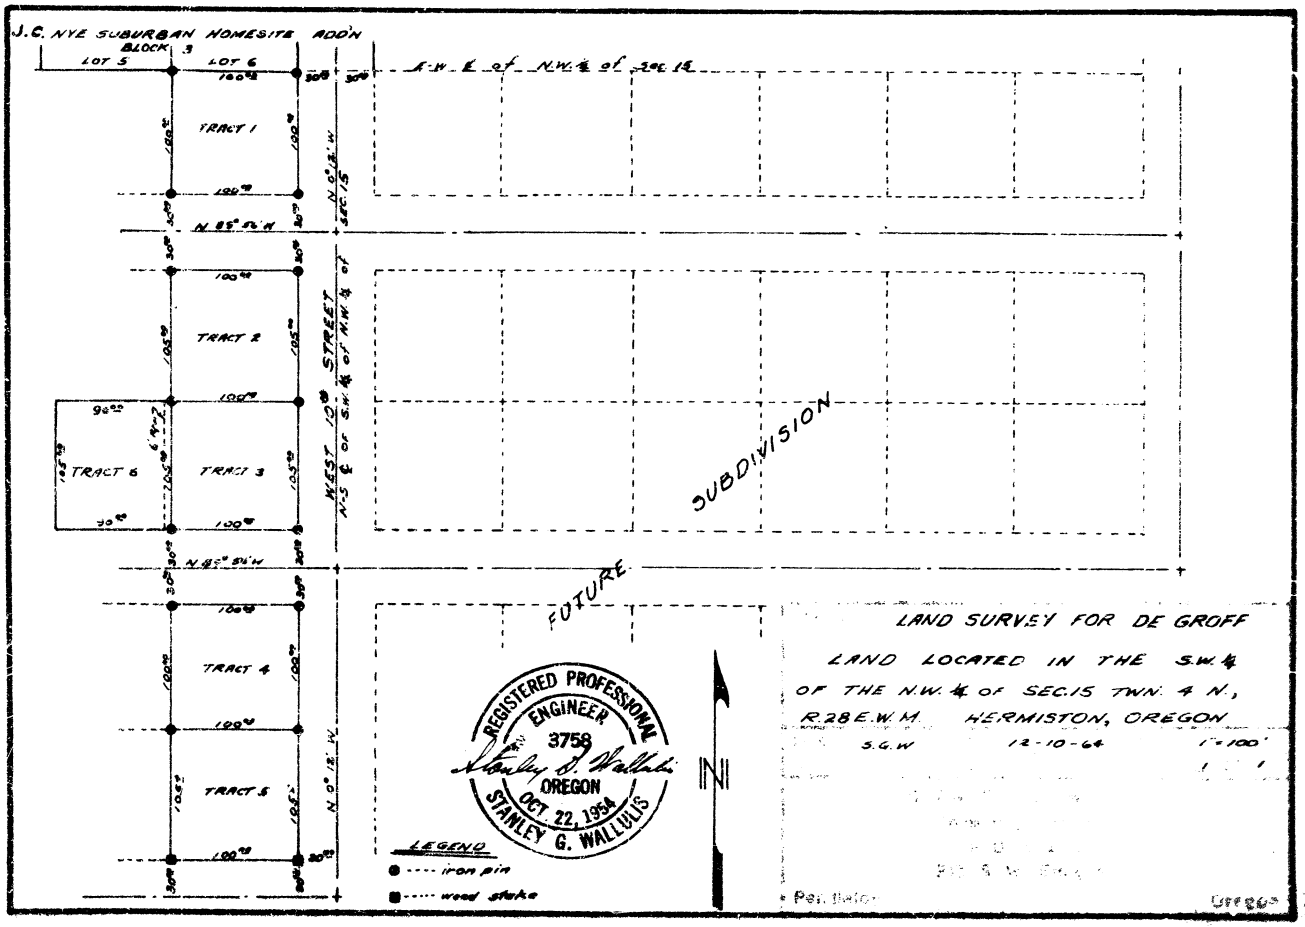
"•" Indicates Iron Pins Set
For lot 2 & W½ lot 3 BLK 7
KIRKS 2nd Add.