


Q-1075-Ax

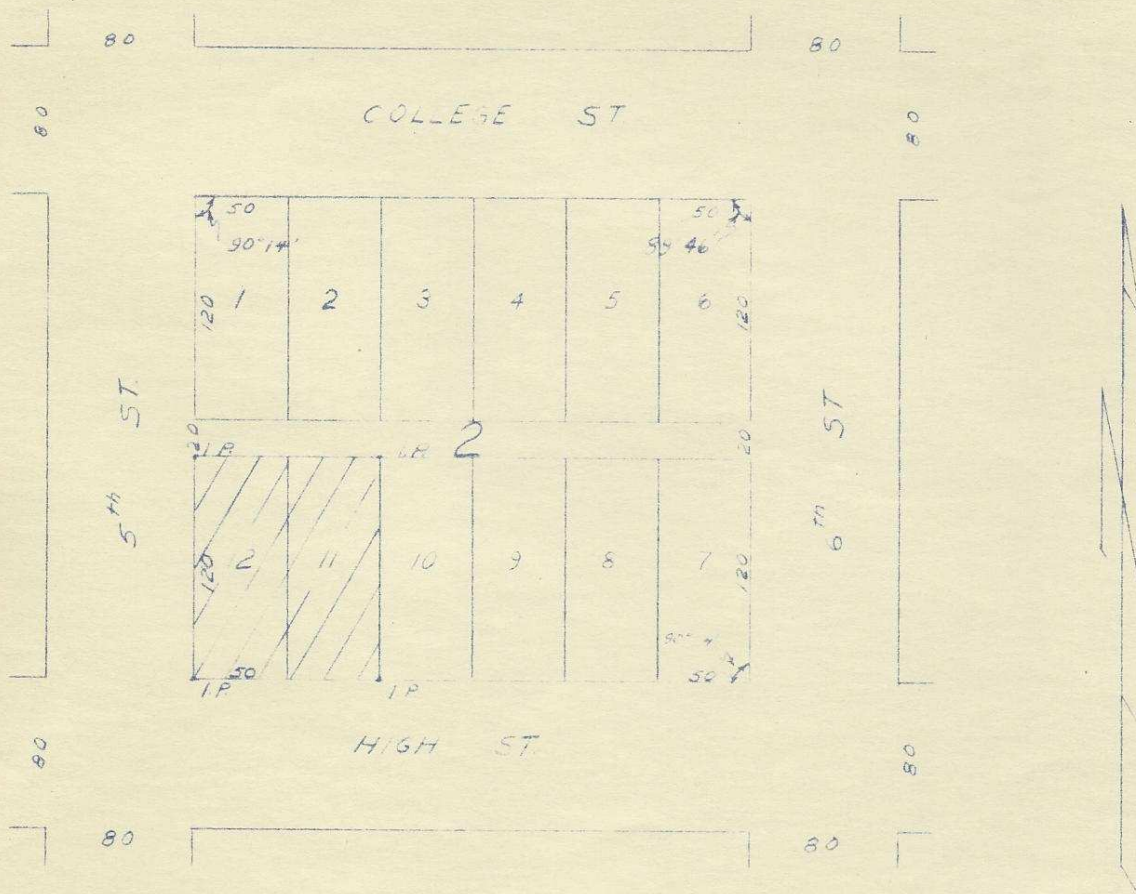

REGISTERED
OREGON
 LAND SURVEYOR

Wayne O. Harris

MAY 6, 1955
 WAYNE O. HARRIS
 346

HAYES AND HARRIS ENGINEERING

ATHENA BAPTIST CHURCH

Lots 11 & 12, Blk. 2, Kirk's 4th Add'n
 Athena, Oregon

Scale	Date	Drn. By	Drng. No.
1"=10'	5/2/57	W.O.H.	