


Q SIXTH ST. — U.S. 730

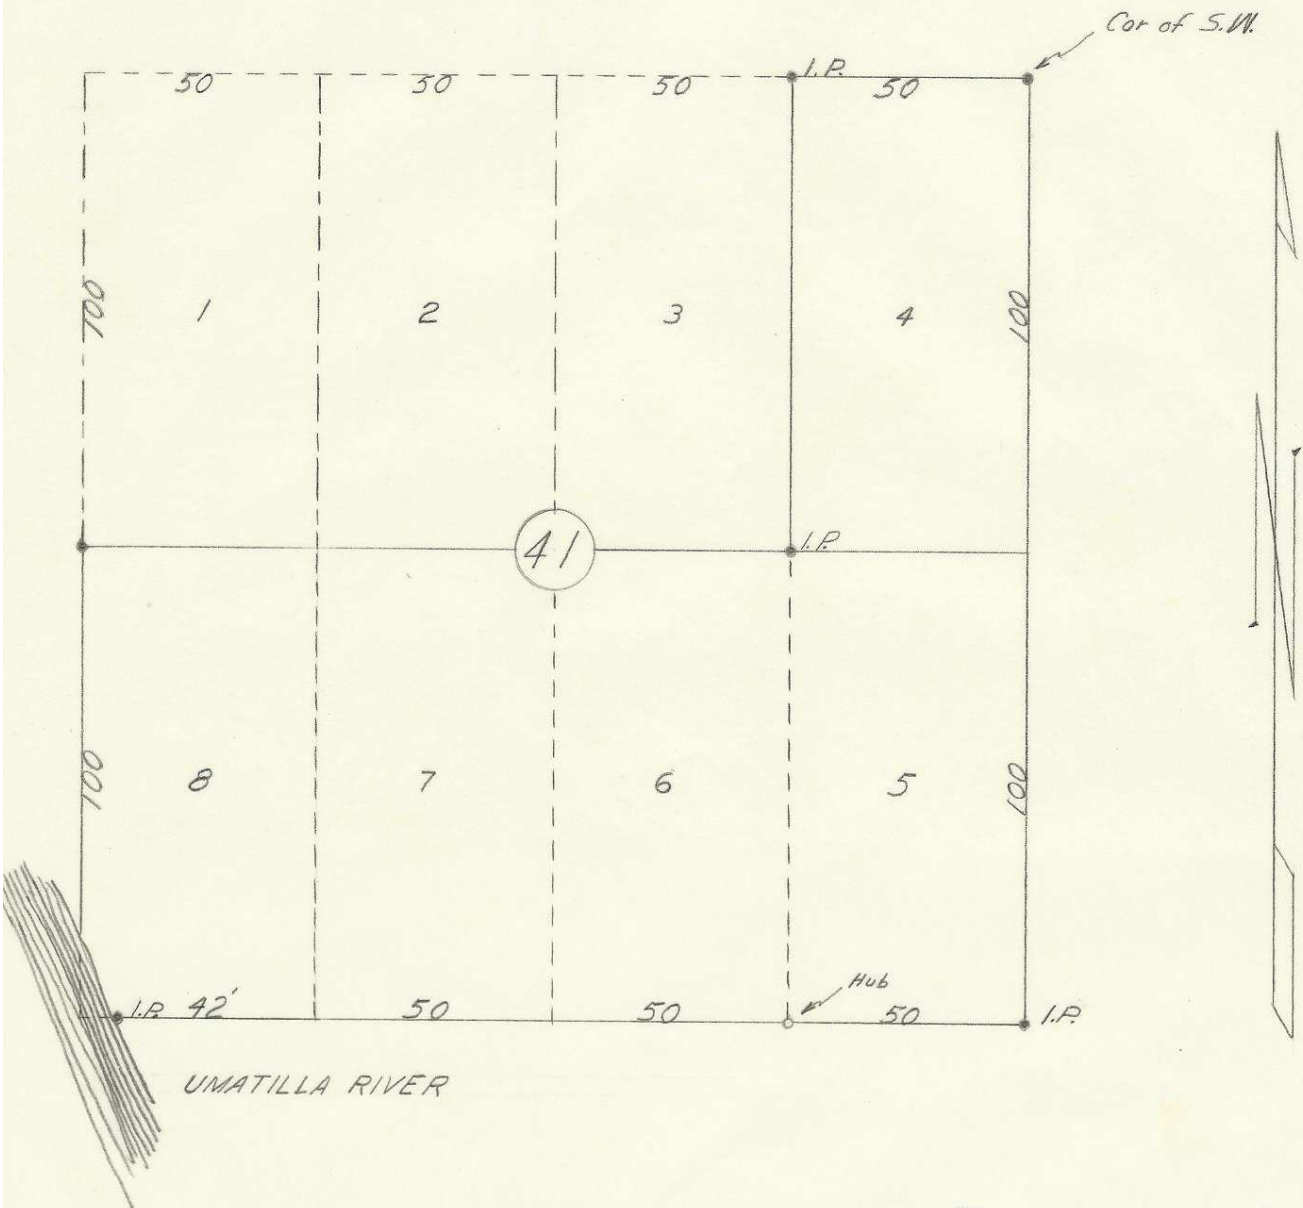

Q-1087-Ax

HAYES & HARRIS ENGINEERING

SURVEY FOR

E. F. HARLAND

LOTS 4, 5, 6, 7, & 8, BLK. 41, ORIGINAL TOWN
UMATILLA, OREGON

REGISTERED
OREGON
LAND SURVEYOR

Wayne O. Harris

MAY 6, 1955
WAYNE O. HARRIS
346

T5N R28 18AD

SCALE
1" = 40'

DATE
3-30-56

DRAWN BY
W.O.H