


E U.S. Highway No 730

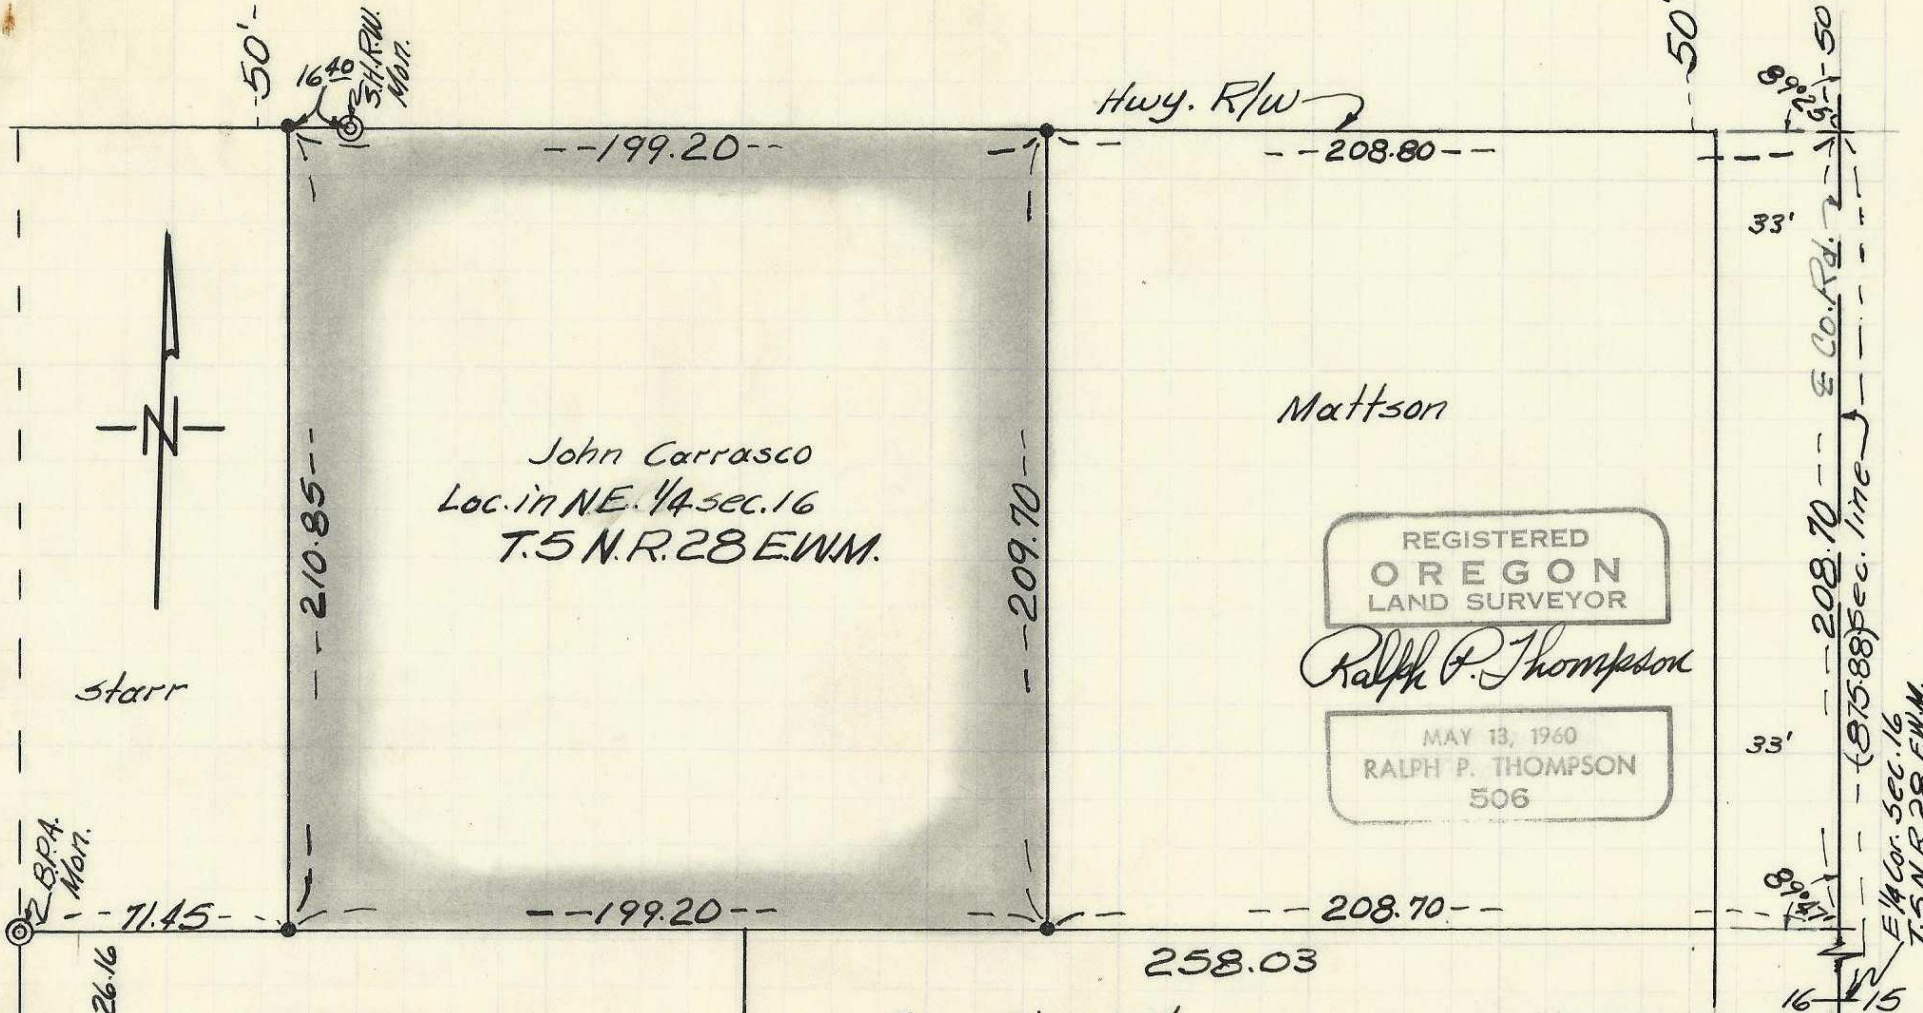

John Carrasco
Loc. in NE 1/4 sec. 16
T.5 N. R. 28 E. W.M.

Mattson

REGISTERED
OREGON
LAND SURVEYOR

Ralph P. Thompson

MAY 13, 1960
RALPH P. THOMPSON
506

starr

- Iron pins set
- ⊙ Brass Capped Mon. End.

U M A T I L L A H G T S.

PROPERTY SURVEY
FOR
JOHN CARRASCO

Scale: 1" = 50' Date: Feb 26, 1962

Ralph P. Thompson
Land Surveyor
Rt. 2. Box 445-A
Pendleton, Oregon

Q-1088-Ax

