

Q-1287

Vernon B Tenneson & Assoc


July 13, 1956

Party - Wallulis

No Scale

Robinson

Eddleman

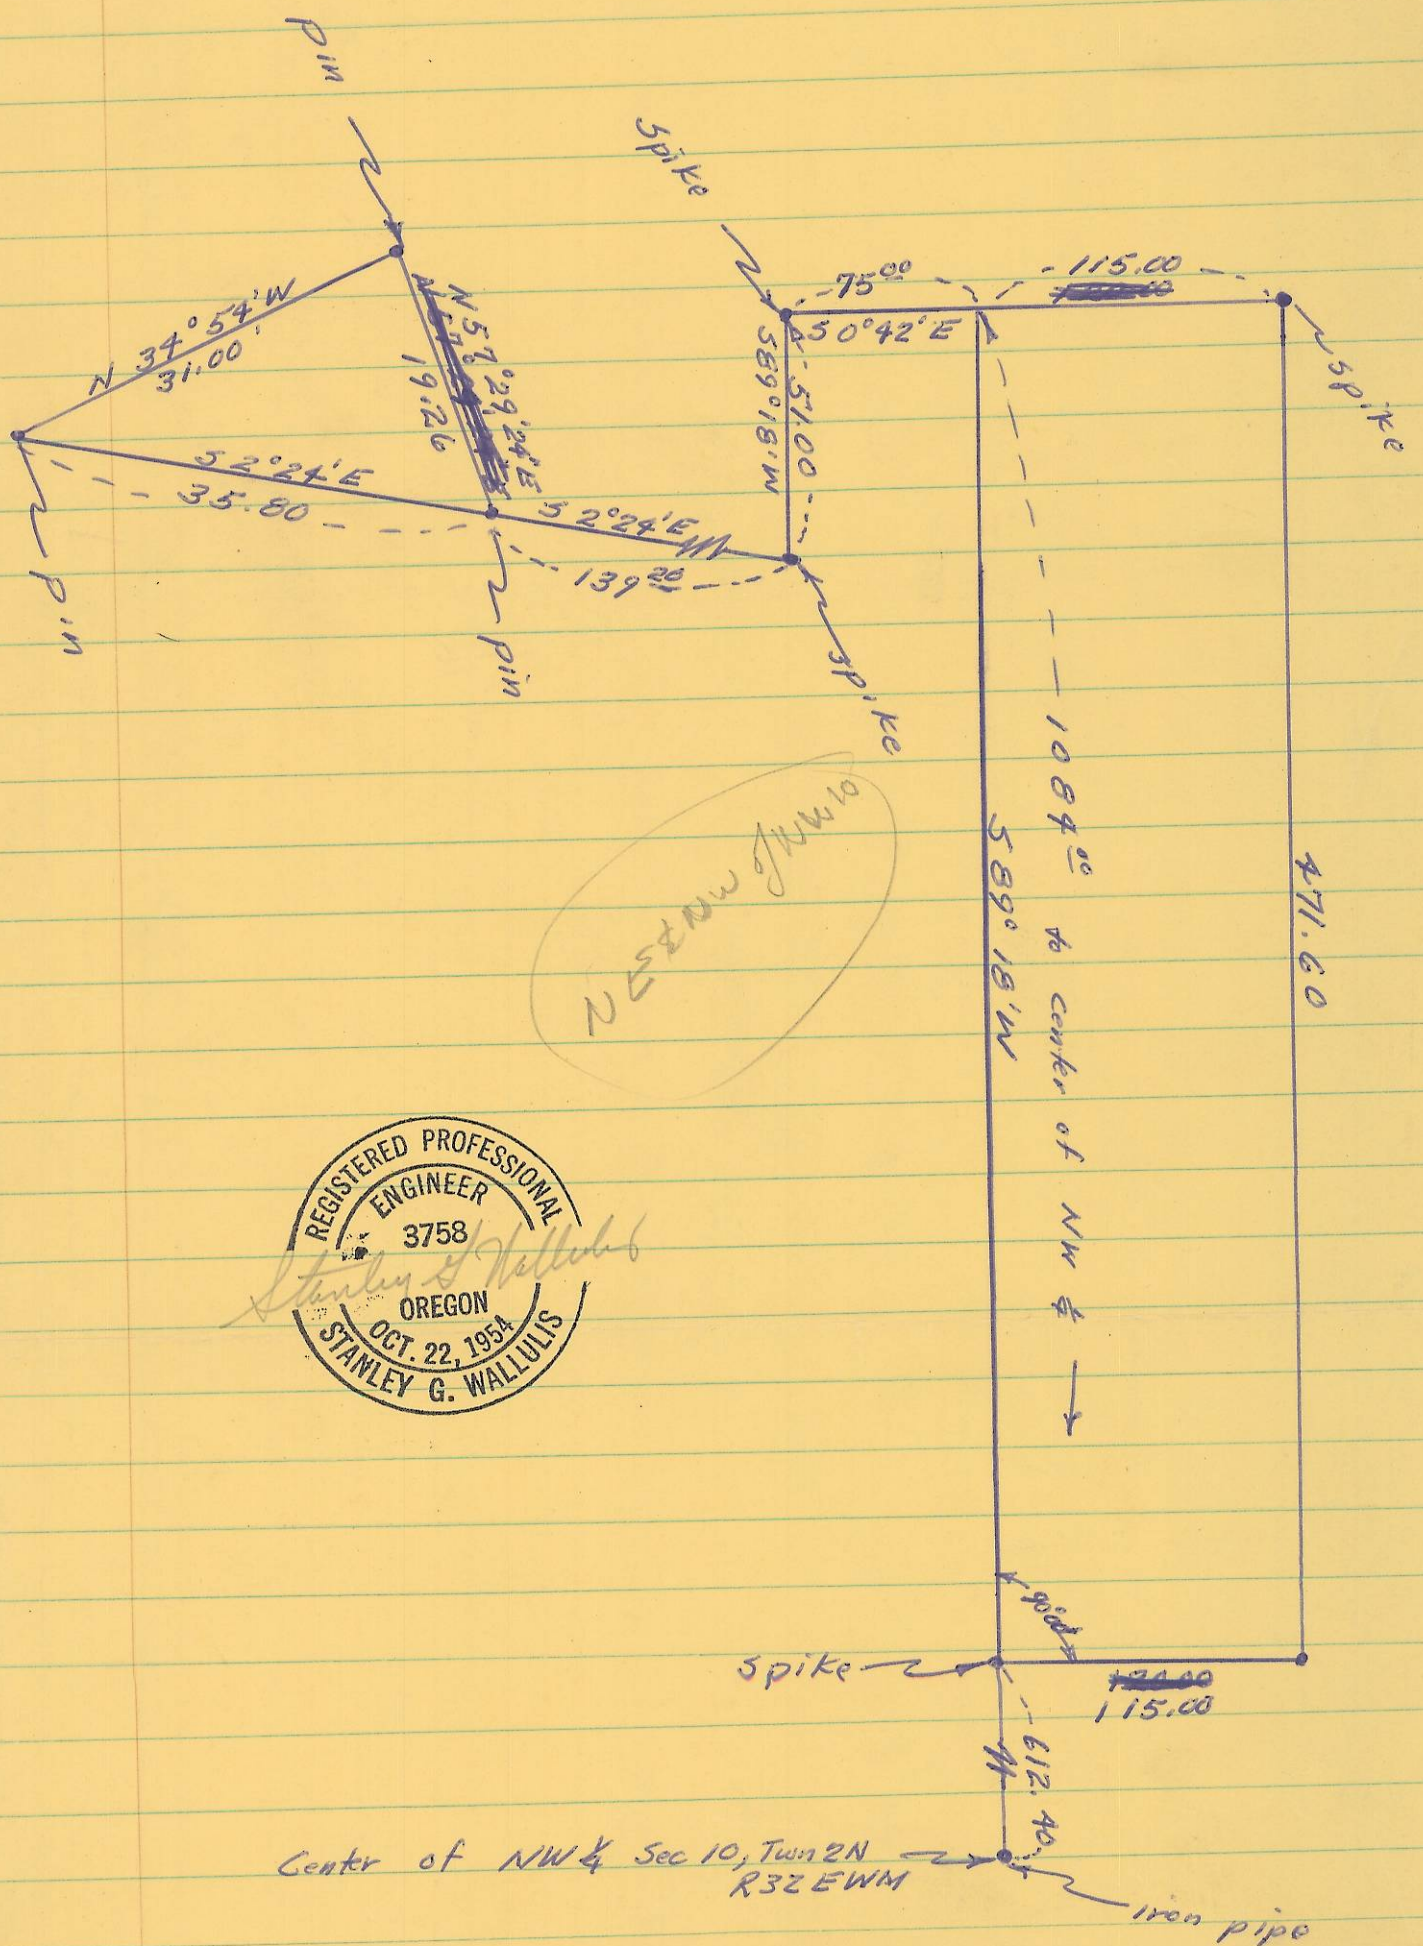




Center of NW 1/4 Sec 10, Twn 2N R32EWM

iron pipe

874  
Q-1287-A