


738

SURVEY FOR HENRY KOPAZE

Sec 13 T4N R28E

Scale 1" = 100'

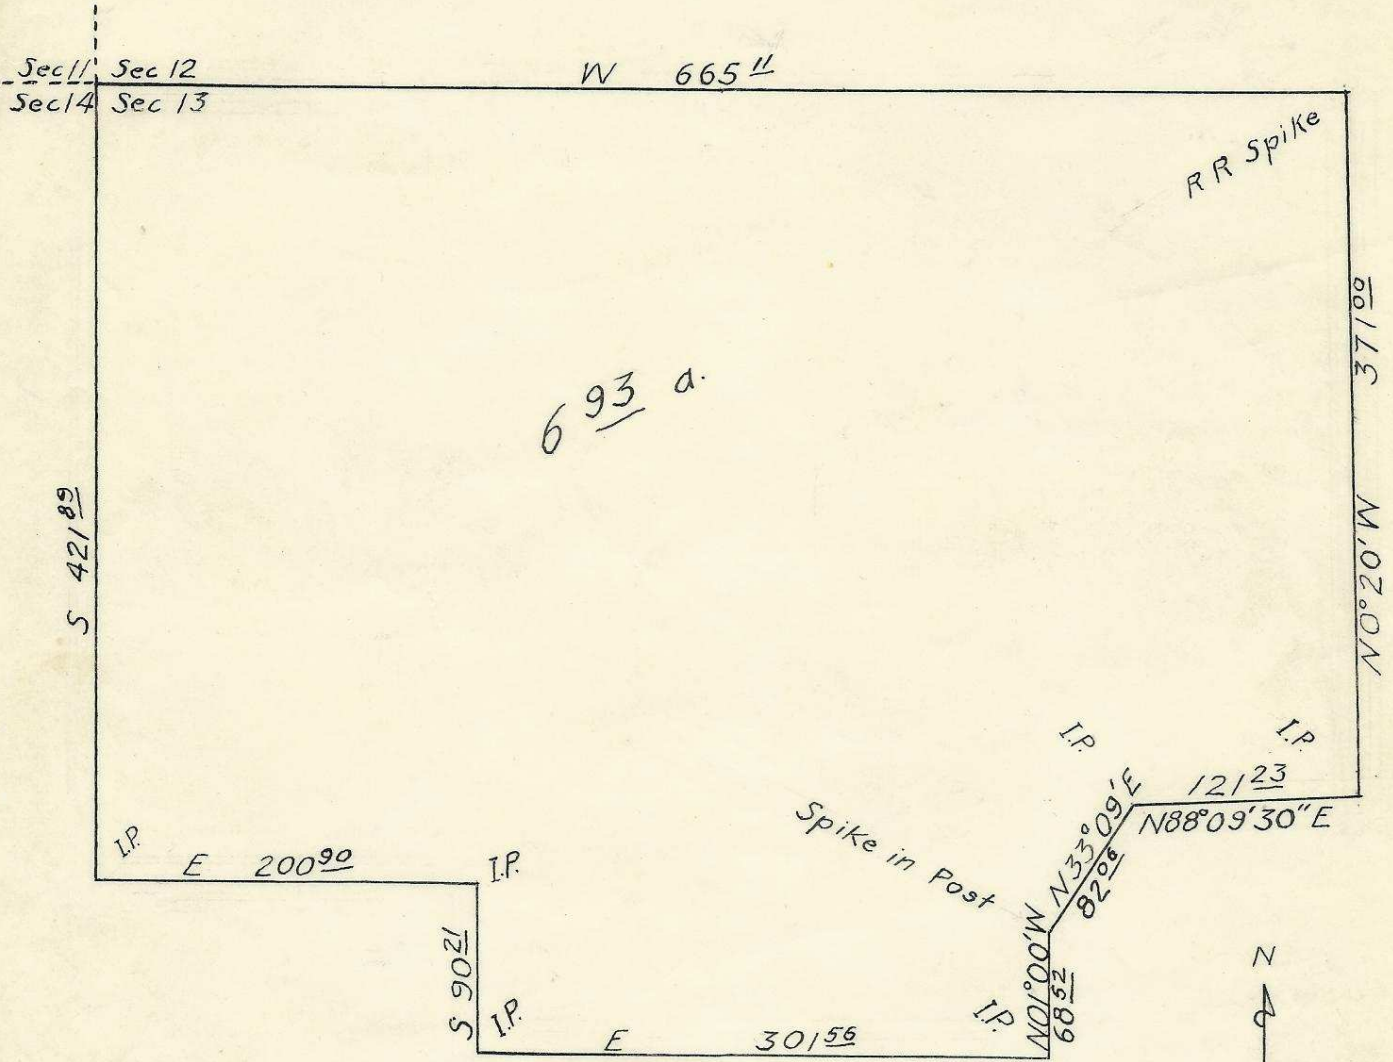

I hereby certify that I correctly surveyed and marked the above shown tract as indicated. Jan 4, 1960.



no repro avail

738
Q-1323-AP