


730

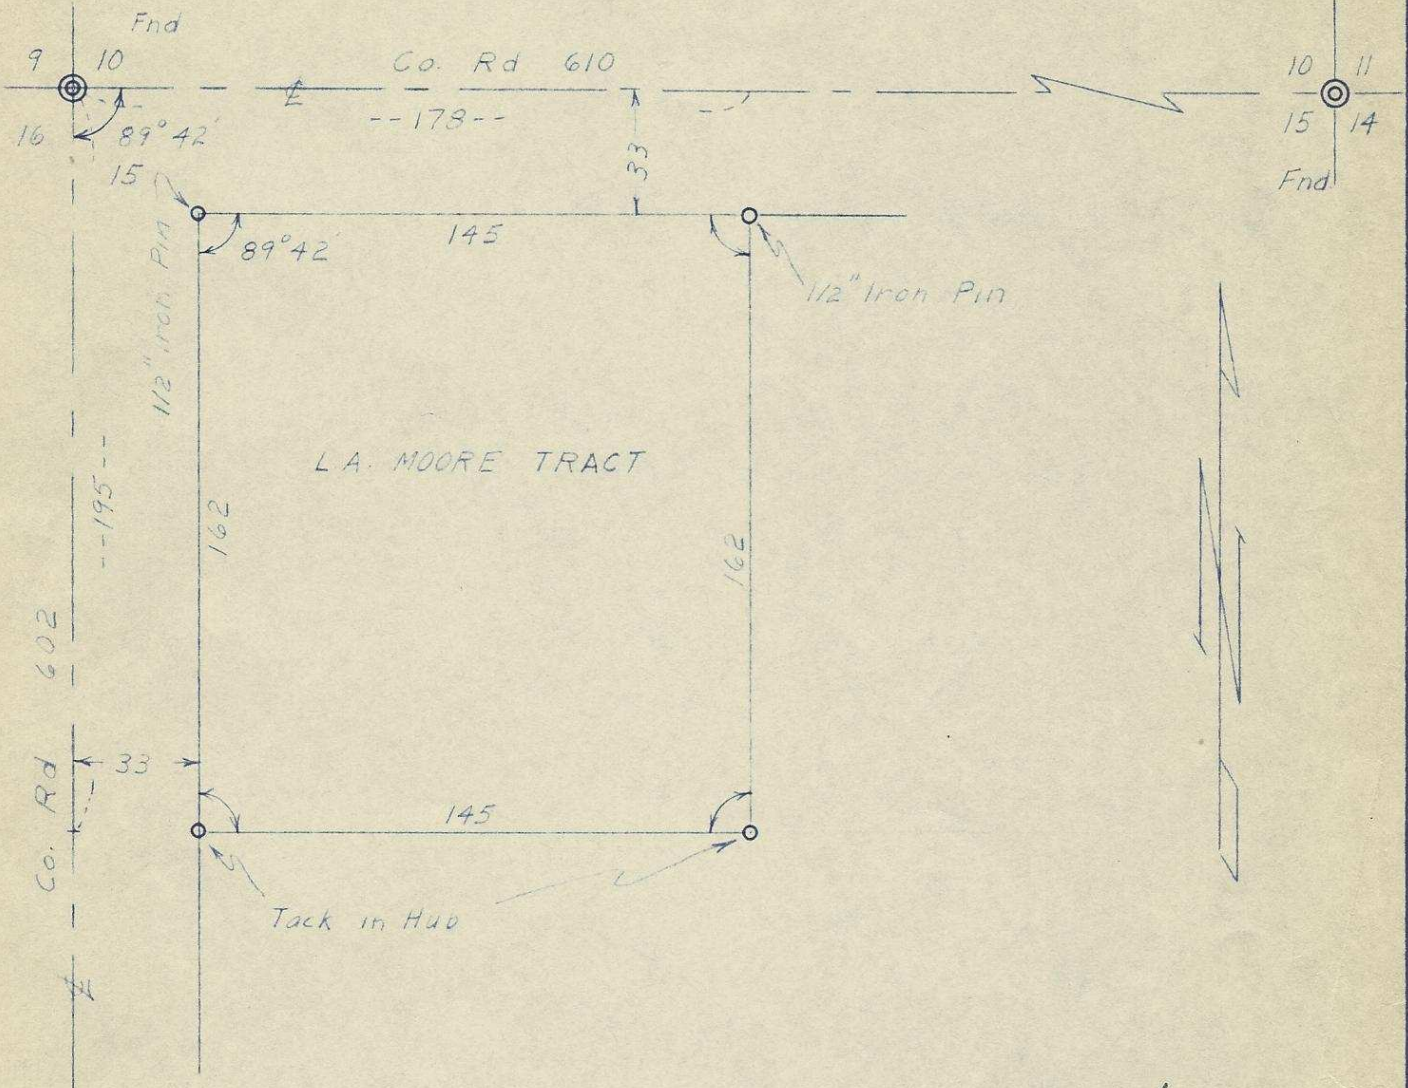

Q-1344-Ax

OREGON LAND SERVICE

Wayne Q Harris

HAYES AND HARRIS

Survey For

L. A. MOORE

Parcel in NW $\frac{1}{4}$ of Section 15
T. 4 N., R. 28 E., W. M.

Scale	Date	Drn. By	Drng. NO.
1"-50	9/20/60	WOH	60-135

no report avail

Q-1344-Ax
730