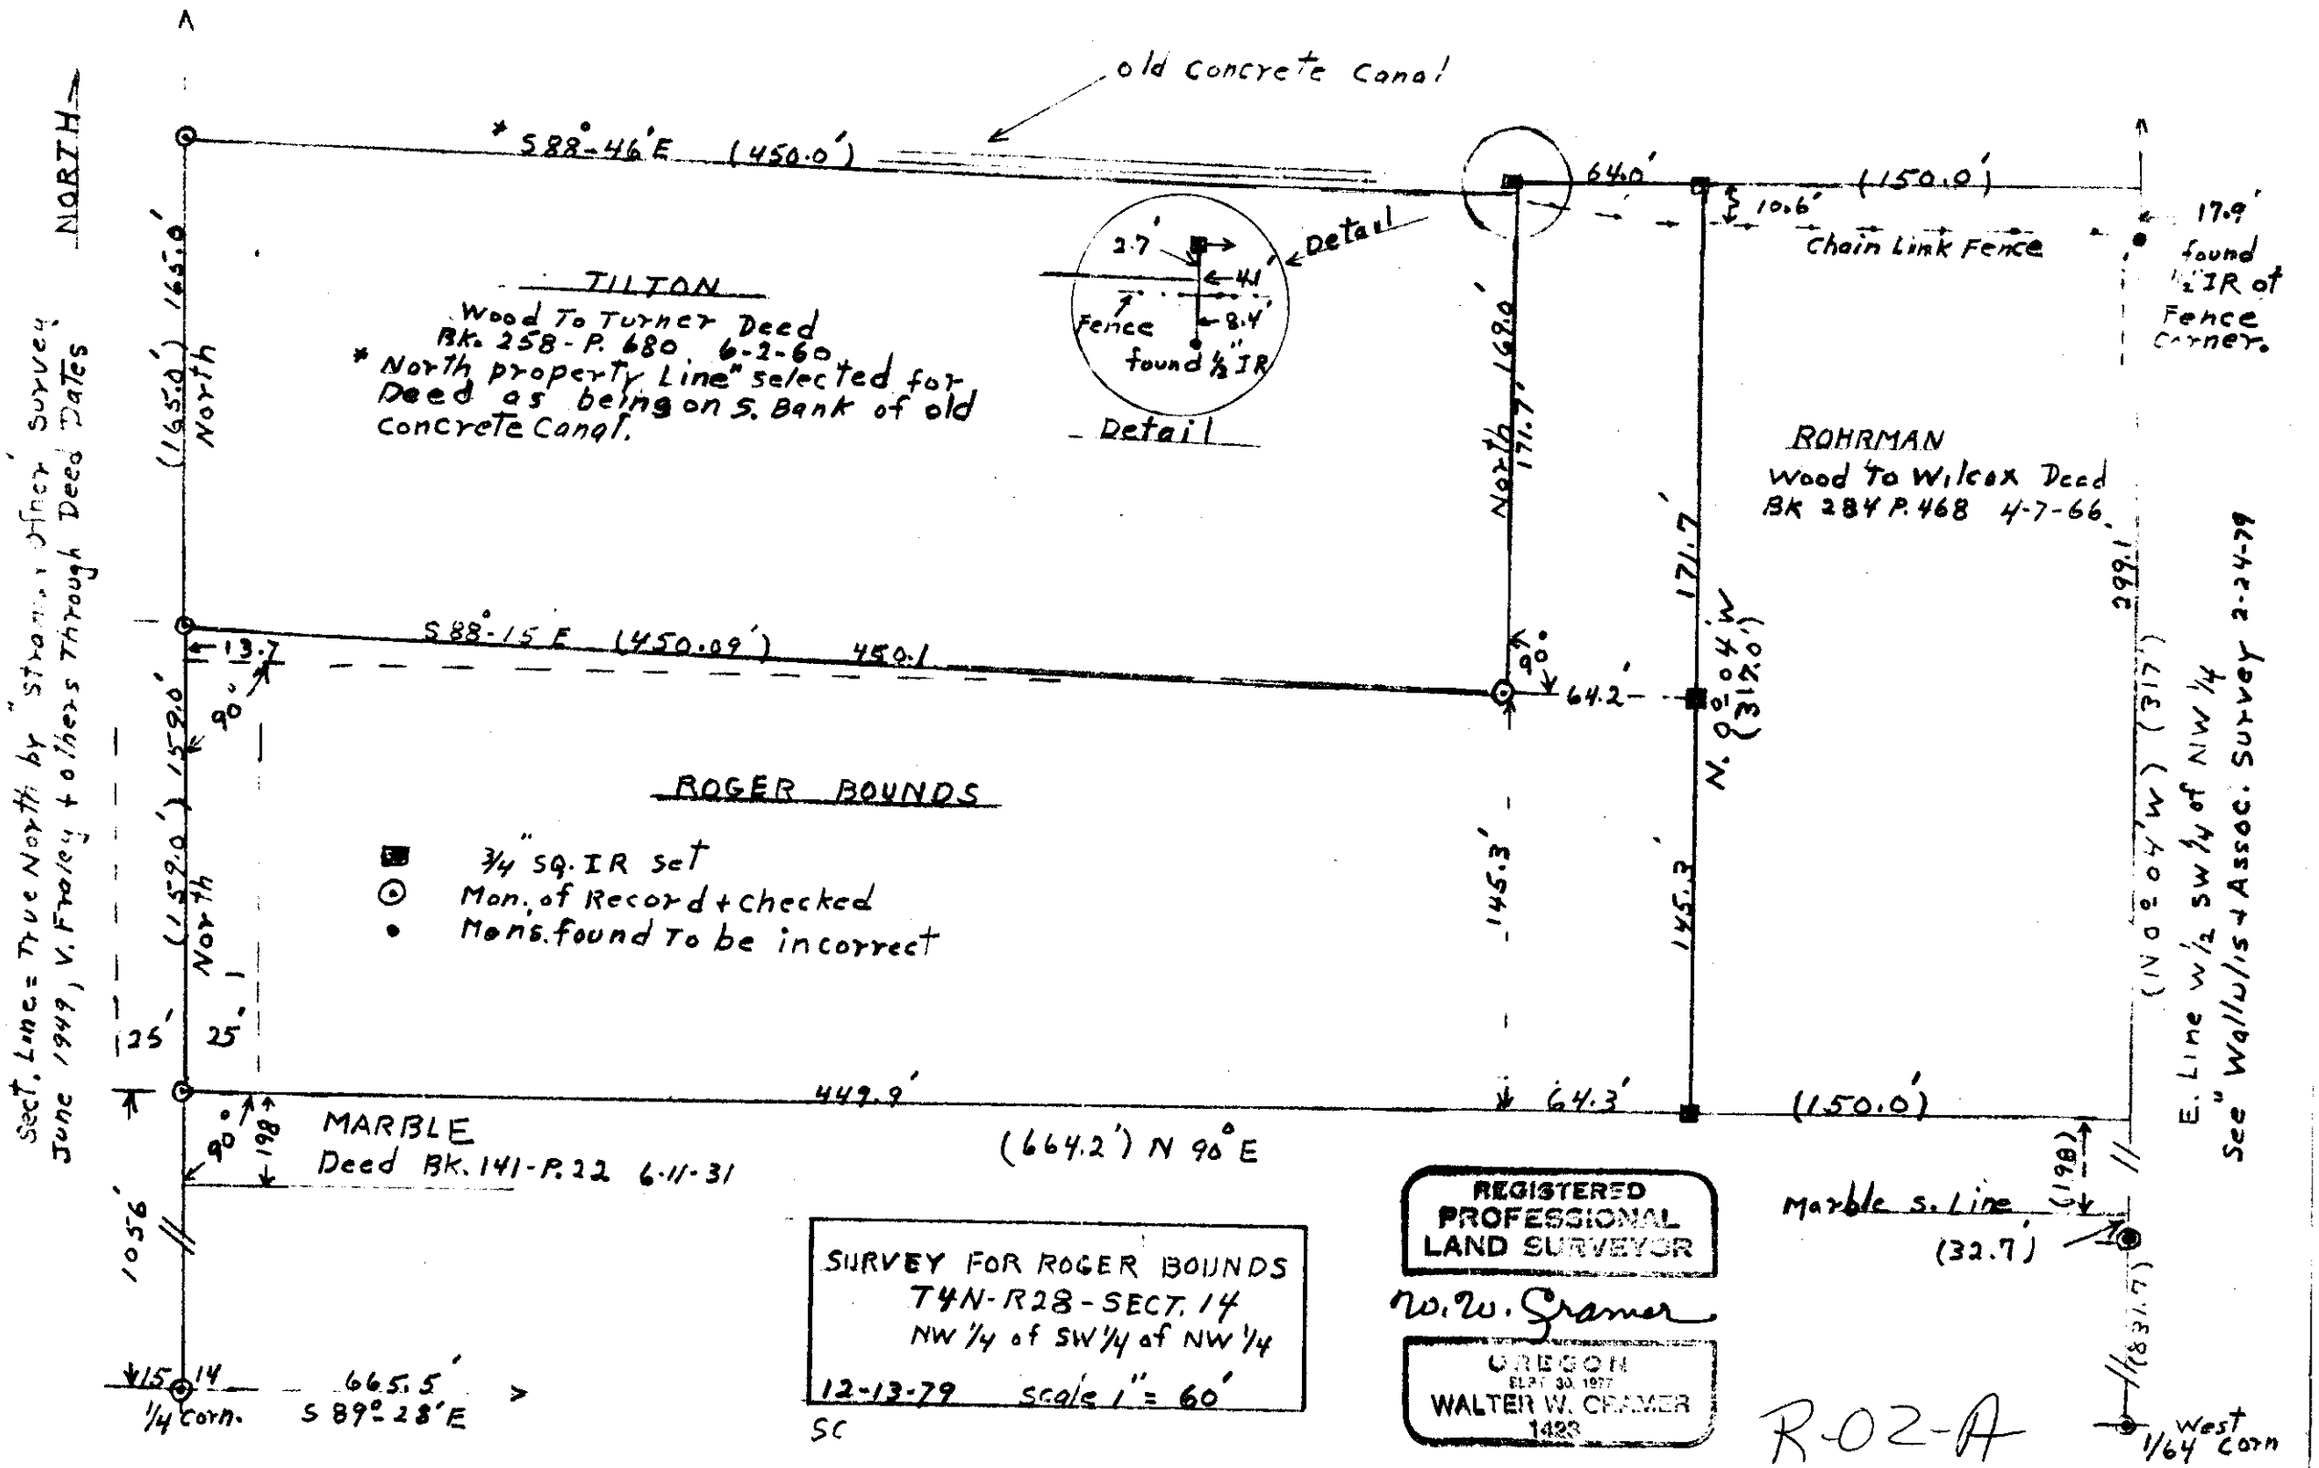
NORTH
old Concrete Canal
* S 88°-46' E (450.0')
64.0'
(150.0')
10.6'
Chain Link Fence
17.9'
found ½" IR of Fence Corner.
TILTON
Wood To Turner Deed
Bk. 258 - P. 680 6-2-60
* North property Line" selected for Deed as being on S. Bank of old Concrete Canal.
Detail
2.7'
4.1'
8.4'
Fence
found ½" IR
Detail
North
North 168.0'
171.7'
ROHRMAN
Wood To Wilcox Deed
Bk 284 P. 468 4-7-66
171.7'
N. 0°-44' W (317.0')
299.1'
S 88°-15' E (450.09') 450.1
13.7
90°
64.2'
ROGER BOUNDS
¾" SQ. IR set
Mon. of Record + checked
Mons. found To be incorrect
145.3'
145.3'
25'
25'
449.9'
64.3'
(150.0')
(664.2') N 90° E
198
MARBLE
Deed Bk. 141 - P. 22 6-11-31
1056'
Marble S. Line
(198)
(32.7')
665.5'
S 89°-28' E
15
14
¼ Corn.
West 1/64 Corn
Sect. Line = True North by "Stromm Officer Survey June 1949, V. Fraley + others Through Deed Dates
E. Line W½ SW¼ of NW¼
See "Wallulis + Assoc. Survey 2-24-79
SURVEY FOR ROGER BOUNDS
T4N-R28-SECT. 14
NW ¼ of SW ¼ of NW ¼
12-13-79 scale 1" = 60'
SC
REGISTERED PROFESSIONAL LAND SURVEYOR
W. W. Cramer
OREGON
SEPT 30, 1977
WALTER W. CRAMER
1423
R-02-A