

# SURVEY IN BLOCK 41, ORIGINAL TOWN OF FREEWATER

Surveyed for Earl Karr By Victor M. McLind

DECEMBER, 1979

SCALE: 1"=50'

REGISTERED  
PROFESSIONAL  
LAND SURVEYOR


*Victor M. McLind*

OREGON  
JULY 17, 1970  
VICTOR M. MCLIND  
934

RECEIVED BY  
Umatilla County Surveyor

Date 1-21-80  
Rec'd By B. Shatt  
No. R-3-A4

NE 5TH ST.

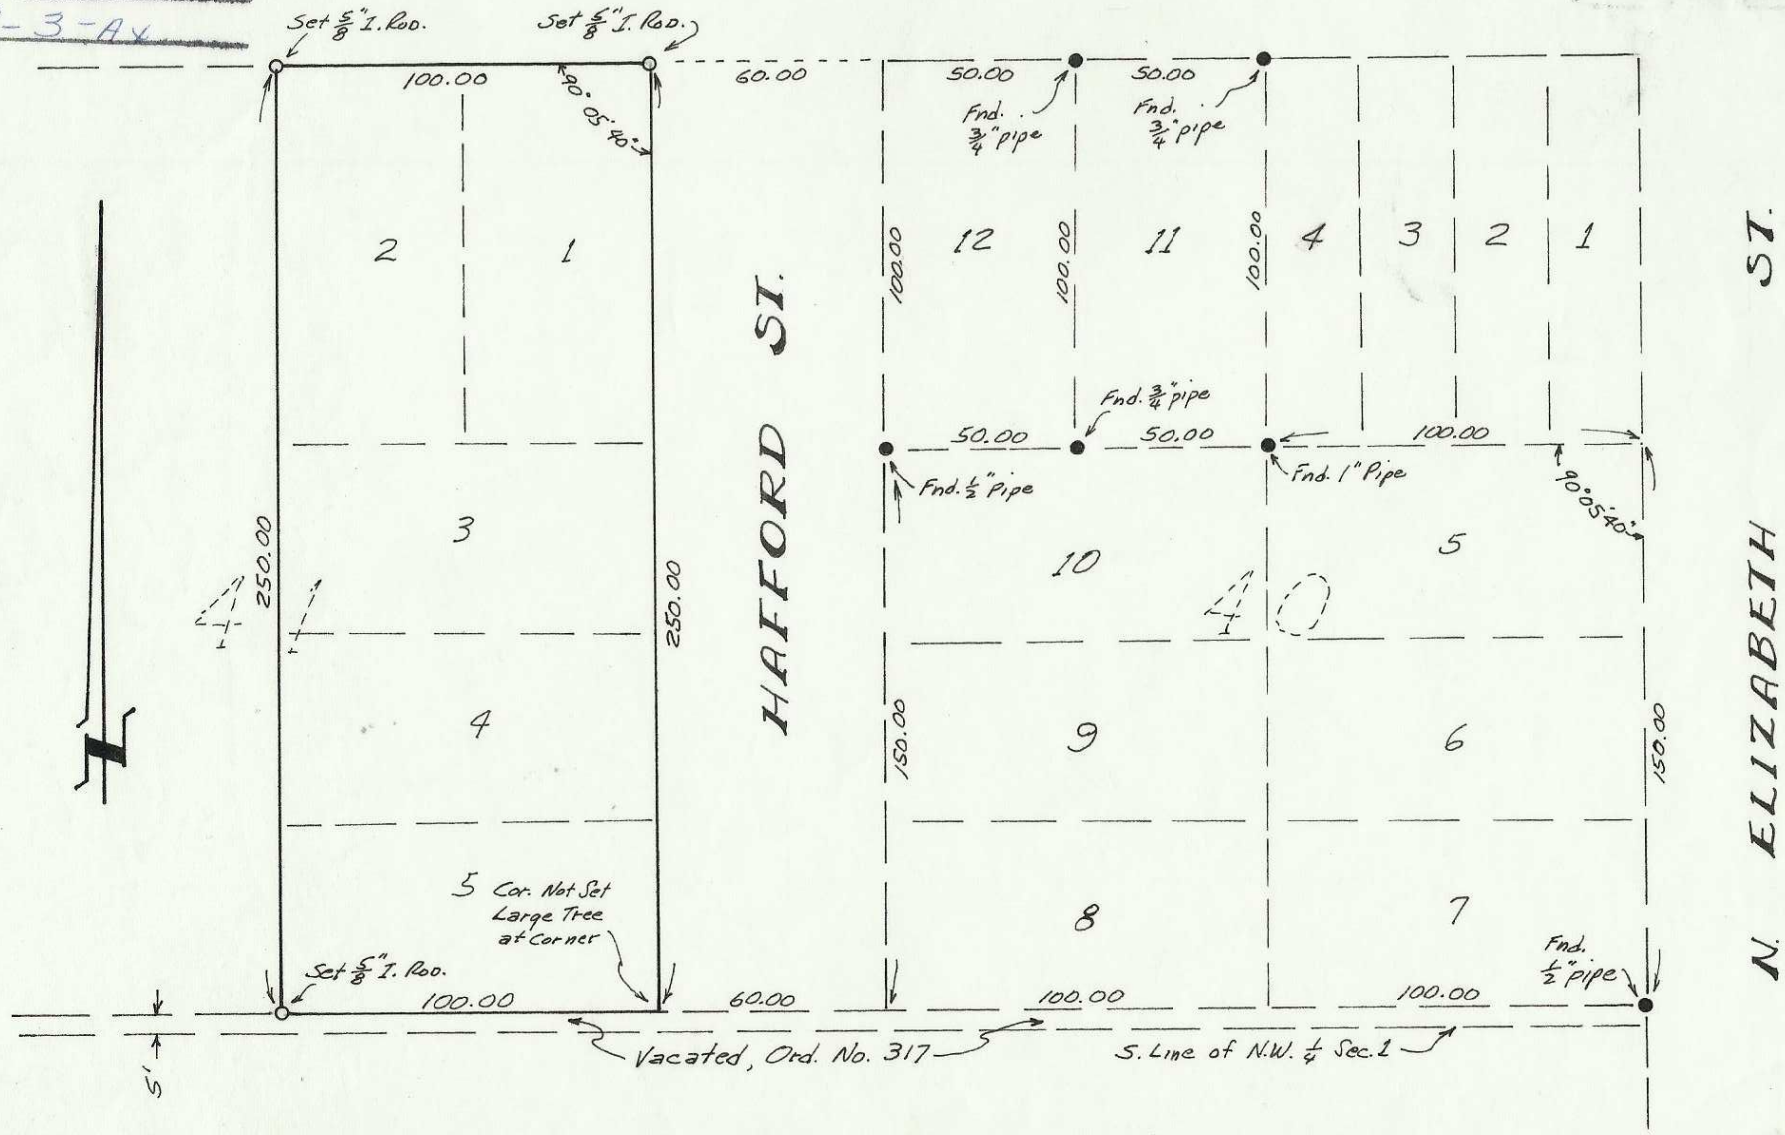

ST.

N. ELIZABETH

Vacated, Ord. No. 317

5. Line of N.W. 1/4 Sec. 1

R-3-A4

SURVEY FOR: Earl Karr

SURVEY BY: Victor M. McLind, Route 3, Box 2, Milton-freewater, OR. 97862

DATE: January, 1980

LOCATION: Block 41, Original Town ow Freewater, now a part of Milton-freewater, Oregon.

BASIS OF BEARINGS: Bearings not shown on map

PROCEDURES FOLLOWED: I located the S.E. corner of Bl. 40, the N.W. and N.E. corners of Lot 10, and the N.E., N.W., and S.W. corners of Lot 11, Bl. 40. (see my survey for Melvin Daniels dated March, 1979)  
I searched for corners in Bl. 41 but found nothing. Since the found corners in Bl. 40 closely matched original plat distances, I used plat distances to locate the corners in block 41 from the found corners in Block 40. All corners were tied or set from a closed traverse.

REGISTERED  
PROFESSIONAL  
LAND SURVEYOR

*Victor M. McLind*

OREGON  
JULY 17, 1970  
VICTOR M. MCLIND  
934

RECEIVED BY

Umatilla County Surveyor

Date 1-21-80

Rec'd By Bl. Shatto

~~No. R-9-8x~~