


E
 300' SD
 S = 27°00'
 d = 60

E
 500' SD
 S = 10°00'
 d = 08

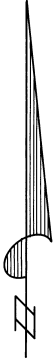

NARRATIVE

The purpose of this survey was to mark the corners of that parcel conveyed to George H. Peterson by Deed recorded on Page 387 of Roll 94, Deed Records, Umatilla County, Oregon. Control used was the survey done by Wayne O. Harris & Associates for the Benaraya Corp., dated September 12, 1969, Umatilla County Survey Records drawing no. G-5-C. The thirty feet was taken perpendicularly to the old property line. Points shown as found were in good condition.

- denotes 3/8 in. x 30 in. iron pin with aluminum cap set
- denotes State Highway pin with 1 in. aluminum cap found
- denotes 1/8 in. iron pin found

RECEIVED BY
 Umatilla County Surveyor
 Date 11-8-82
 Rec'd by BLS
 No. 82-134-B

REGISTERED
 PROFESSIONAL
 LAND SURVEYOR
David H. Krumbein
 OREGON
 DAVID H. KRUMBEIN
 933

K KRUMBEIN ENGINEERING CO
 ENGINEERS SURVEYORS PLANNERS
 2215 Main, Pendleton, Oregon
 Survey for
GH. PETERSON
 Located in SE 1/4, SE 1/4, Section 9, T2N, R32E, W1M.

Scale
 1" = 100'
 DATE
 October 6, 1982
 DRAWN BY
 KRH
 CHECKED BY
 MH