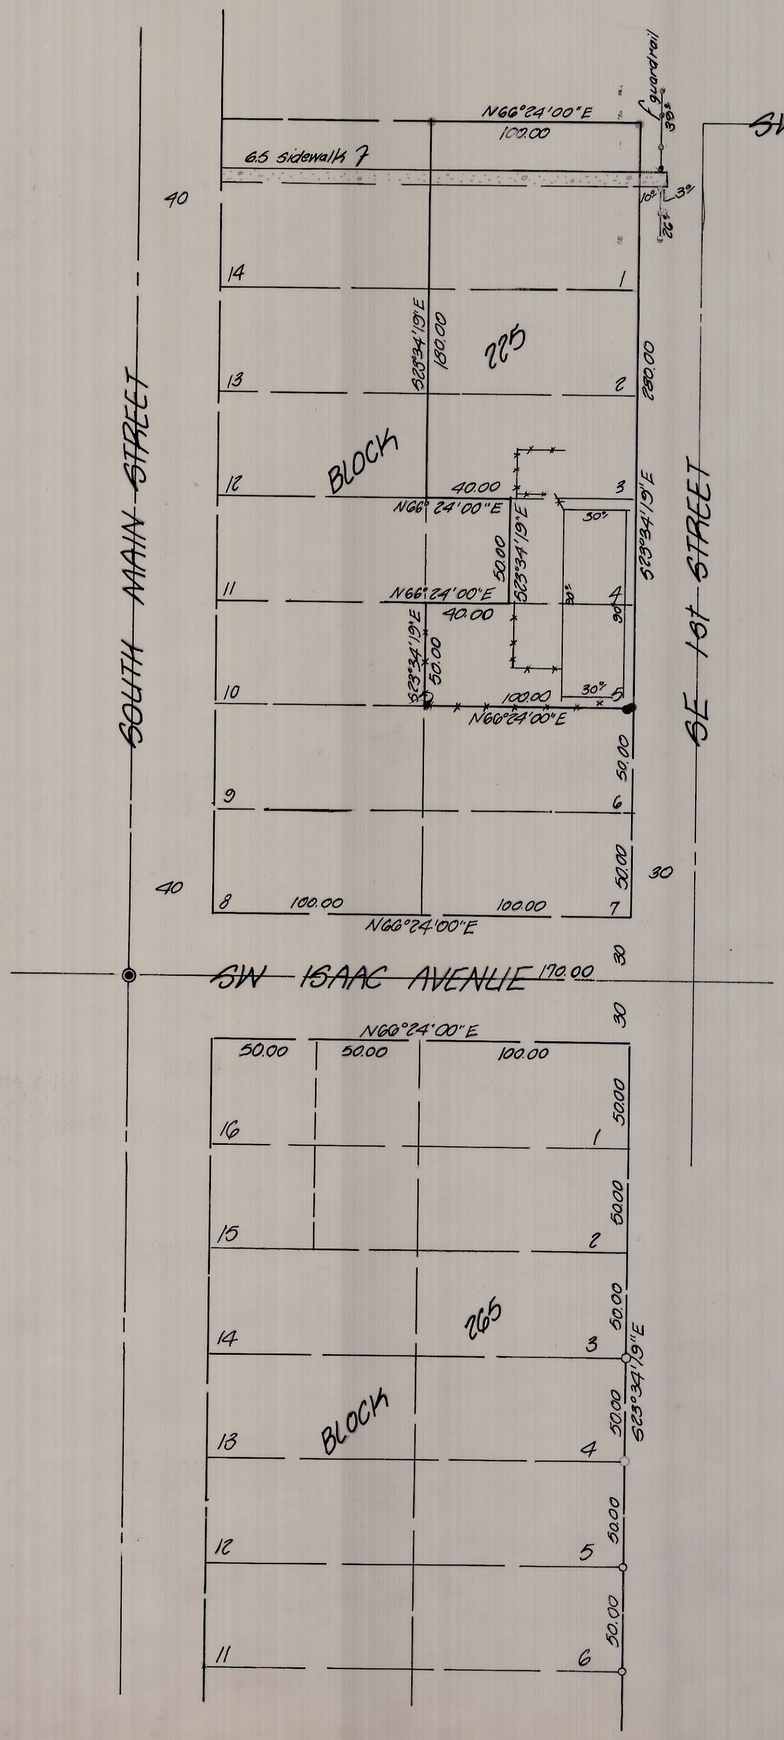

NARRATIVE:

The purpose of this survey was to locate the building improvements and lot lines for Lots 1, 2, 3, 5 and the Easterly 60.00 feet of Lot 4, and the Southerly 30.00 feet of vacated S.W. Hailey adjacent to Lot 1 all in Block 225 of Reservation Addition to the City of Pendleton.

Bearings are based on a survey by Krumbein Engineering for Al Pedro, Umatilla Co. Surveyor No. 83-163-A.

The Plat of Reservation Addition to the City of Pendleton was used for distances.

- • denotes set 5/8" x 30" iron pin with aluminum cap stamped PLS 933
- ○ denotes find 5/8" iron pin set by Krumbein for Al Pedro, Umatilla Co. Surveyor No. 83-163-A
- ⊕ denotes find 5/8" iron pin set by Bill Wells for Everett Sime, Umatilla Co. Surveyor No. 83-177-B.
- ◉ denotes find Brass Cap set by the City of Pendleton

KRUMBEIN ENGINEERING LTD.
ENGINEERS — SURVEYORS — PLANNERS
361 S.E. Second Pendleton, Oregon

Scale	Drn. By	Drng. No.	Revision 1
1"=50'	MLD	85-07C	
Date	Ckd. By	Job No.	Revision 2
2-12-85	DHK	85-10	

Survey for

RICHARD HAMPTON

NW¼, SW¼, Sec 11, T2N, R3CE, W.M.

REGISTERED PROFESSIONAL LAND SURVEYOR
OREGON
DAVID H. KRUMBEIN

RECEIVED BY
Umatilla County Surveyor
Date 3/25
Rec'd By bc
No. 35-38-B