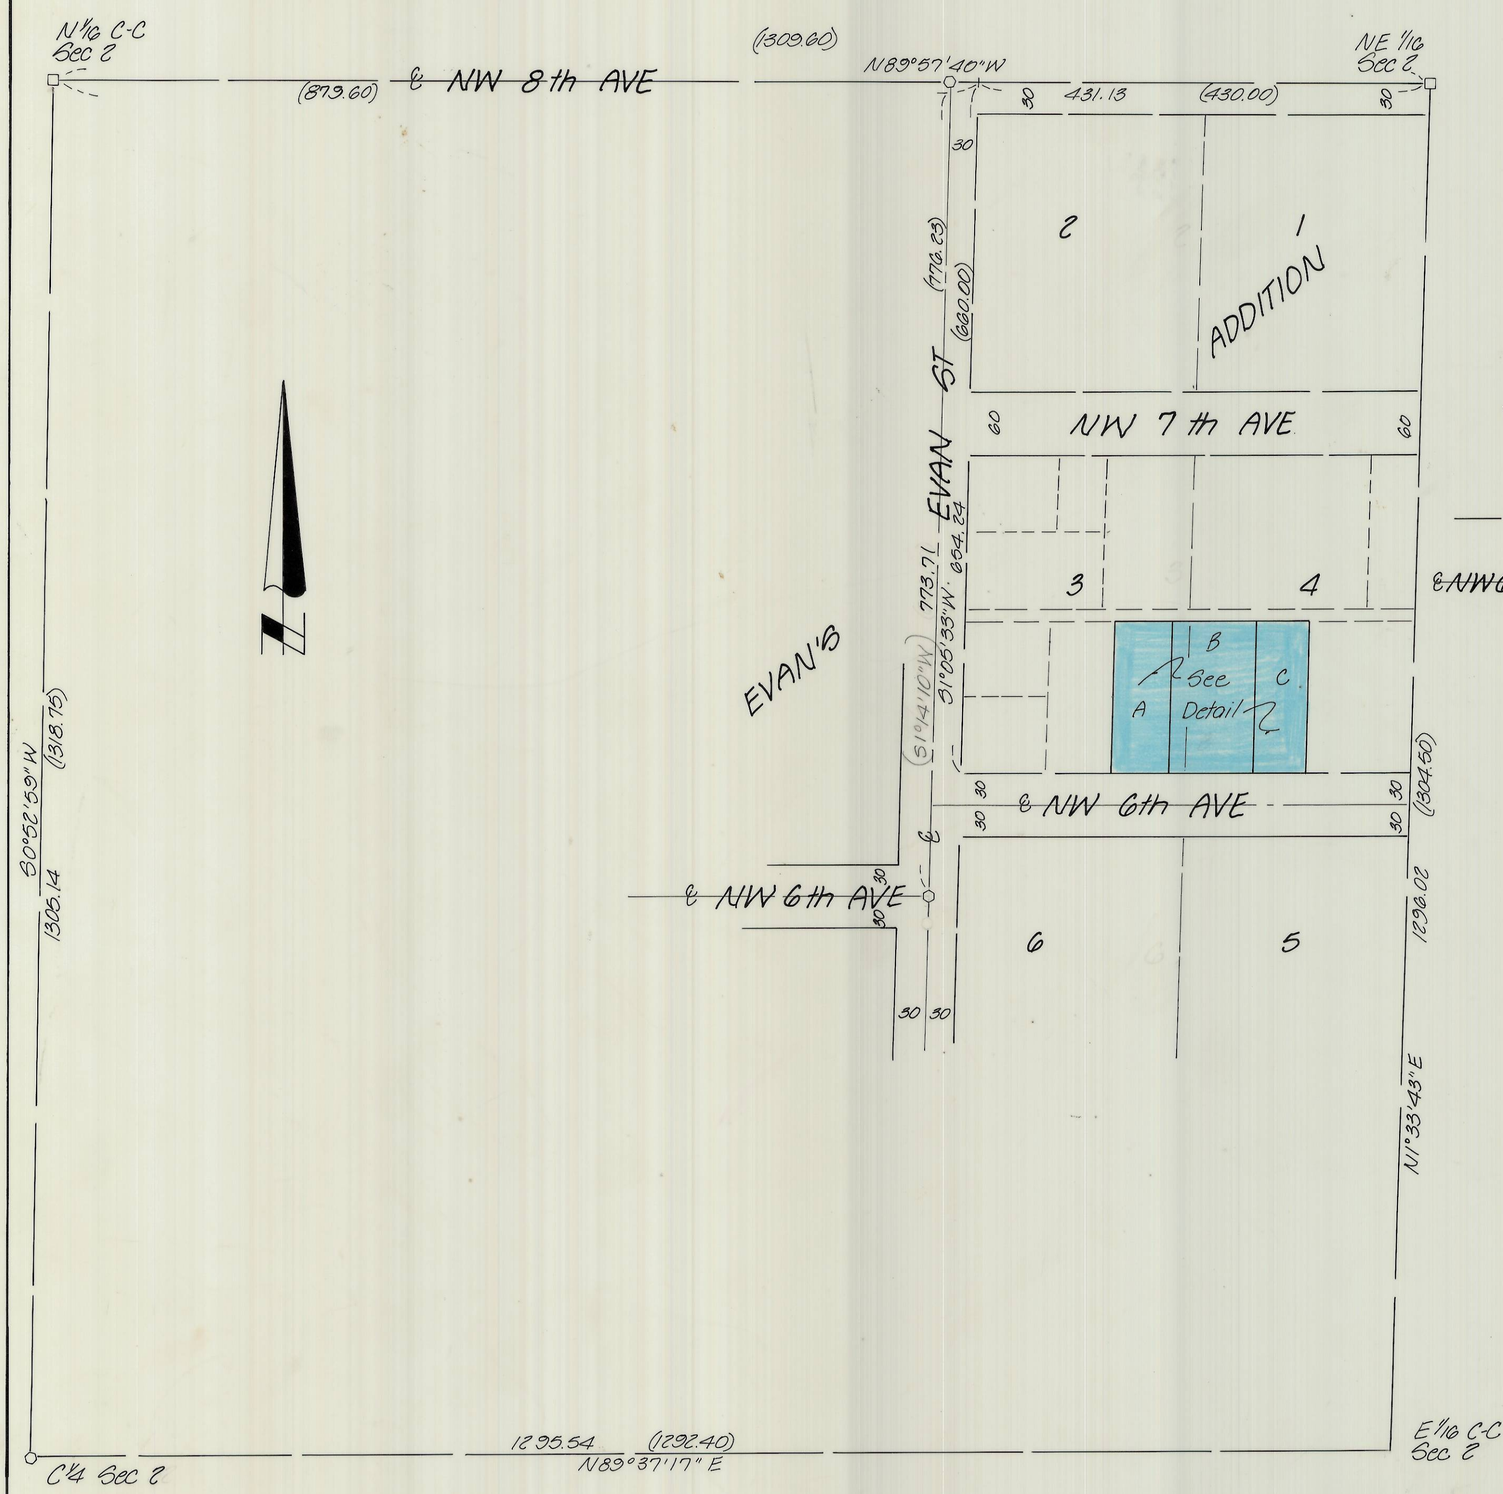

SW 1/4 of the NE 1/4, Section 2
1" = 100'

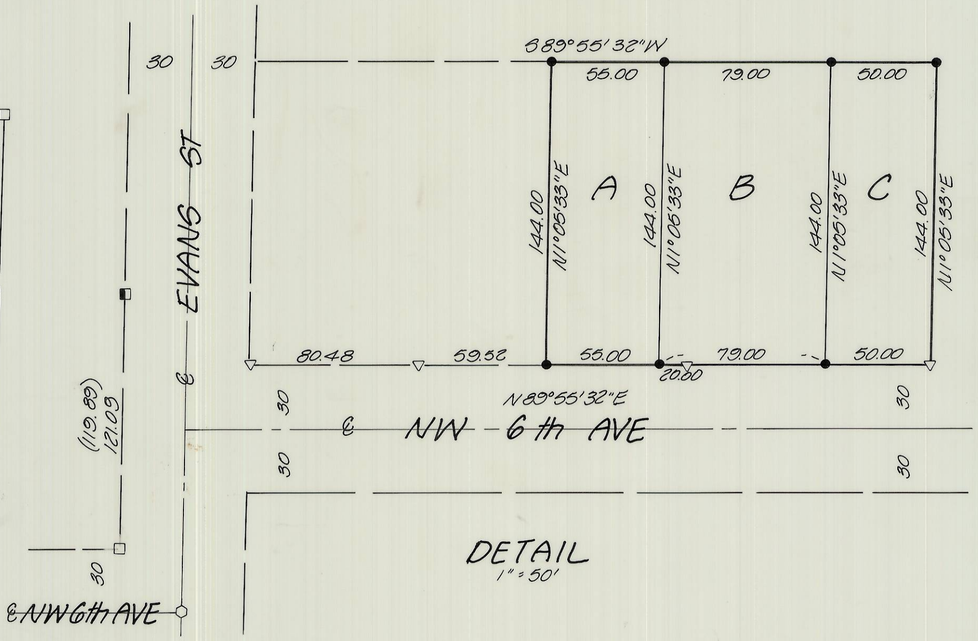

DETAIL
1" = 50'

NARRATIVE:

The purpose of this survey was to set the corners of that part of Blocks 3 and 4 in Evans Addition to the Town of Milton located in the SW 1/4 of the NE 1/4 of Sec. 2, T5N, R35E, W.M., belonging to Rod Giles.

Along the South line of Block 3 we found various monuments as noted. These monuments do not fit the plat locations as the distances of the exterior lines on the plat do not match the actual measured distances by as much as 13.61 feet on the West line.

The monuments we found do fit the existing road center lines so we held this line for the East-West running lines. The North-South running lines were determined from using the Plat distances from the N 1/16 C-C Easterly along the North line of the plat to a point on the extended West line of Block 2 and inversing to the found monument at the SW corner of Block 3.

Bearings are based on Krumbein Eng. survey for the City of Milton-Freewater dated 3-21-85.

- ● denotes set 5/8" x 30" iron pin with aluminum cap stamped PLS 933
- ○ denotes fnd P.K. iron
- □ denotes fnd 5/8" iron pin
- ◧ denotes fnd 1½" i.d. pipe
- ▽ denotes fnd ½" i.d. pipe

938-3806

KRUMBEIN ENGINEERING LTD. ENGINEERS – SURVEYORS – PLANNERS 361 S.E. Second Pendleton, Oregon	Scale (as shown)	Drn. By MLD	Drng. No. 85-47C	Revision 1
	Date 8-29-85	Ckd. By DHK	Job No. 85-109	Revision 2

Survey for

GILES

Evans Addition

SW 1/4, NE 1/4, Sec. 2, T5N, R35E, W.M.

REGISTERED PROFESSIONAL LAND SURVEYOR
David H Krumbein
OREGON JULY 19, 1985 DAVID H. KRUMBEIN 933

RECEIVED BY
Umatilla County Surveyor
Date 10-14-85
Rec'd By KJ
No. 85-139-B