

LANDS OF NELSON



CITY OF PENDLETON PROPERTY LINE SET 5/8" PIN

FD. FENCE COR.
(SEE NOTE B)
(63,235.088)
(36,438.336)

29 28 (SEE NOTE A)
32 33 (62,875.161)
(37,190.819)

LANDS OF NELSON

P.O.T. FD. BRASS CAP
(62,131.148)
(37,181.554)

N 0° 42' 49" E - 2300'

SET 5/8" PIN

S 87° 43' 15" E - 985.27'

S 89° 16' 03" E - 450.00'

SET 5/8" PIN

FD. BRASS CAP

32 33

N 0° 42' 49" E - 693.83'

PROPERTY LINE

LANDS OF NELSON

CITY OF PENDLETON

PROPERTY LINE

S 0° 43' 19" W - 969.69'

PROPERTY LINE

N 0° 43' 57" E - 2645.73'

CITY OF PENDLETON

PROPERTY LINE

S 0° 43' 53" W - 2267.24'


CITY OF PENDLETON

PROPERTY LINE

S 89° 36' 03" W - 450.00'

SET 5/8" PIN

LANDS OF SCHUENING

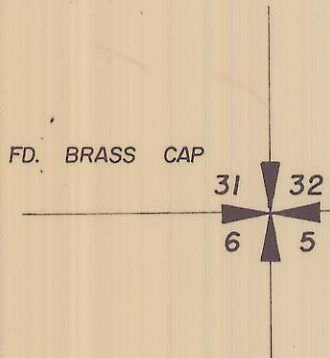

S 89° 51' 05" W
2615.23'

T 3 N R 32
T 2 N R 32

FD. BRASS CAP
(57,589.393)
(34,506.721)

5

S 89° 51' 17" W
2615.49'

FD. CONC. MON


32 33
5 4

NOTE:

(A) SECTION CORNER 29|28
32|33 NOT FOUND.

LOCATION ESTABLISHED BY HOLDING FOUND
P.O.T. AND 1/4 CORNER 32/33 AND
GIRARDS TIE INFORMATION, EVIDENCE OF
CONCRETE FOUND AT THIS POINT.

(B) FENCE CORNER NOTED IS LOCATED
360.00' NORTH AND 758.00' WEST OF
THE SE CORNER OF SECTION 29 T3N
R32 E.W.M., ESTABLISHED BY GIRARD
AS A TIE TO SAID SECTION CORNER
DATE MAY, 1968.

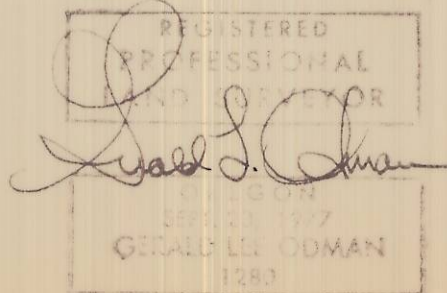

RECEIVED BY
Umatilla County Surveyor
Date 12-89
Rec'd by [Signature]
No. 89-123-B

CITY OF PENDLETON ENGINEERING DEPT.		
SURVEY FOR AIRPORT LAND ACQUISITION		
DATE: 8-1-78	SCALE: 1" = 400'	SHEET 1 OF 1
DN: FLY	CKD: 24-7792	

89-123-B