


- Found Section Corner as Noted
 - Found Quarter Section Corner as Noted
 - Set 5/8"x24" Rebar w/ Plastic Cap "OR 2166LS"
 - Found Monument as Noted
- [Record per Reference Doc #]

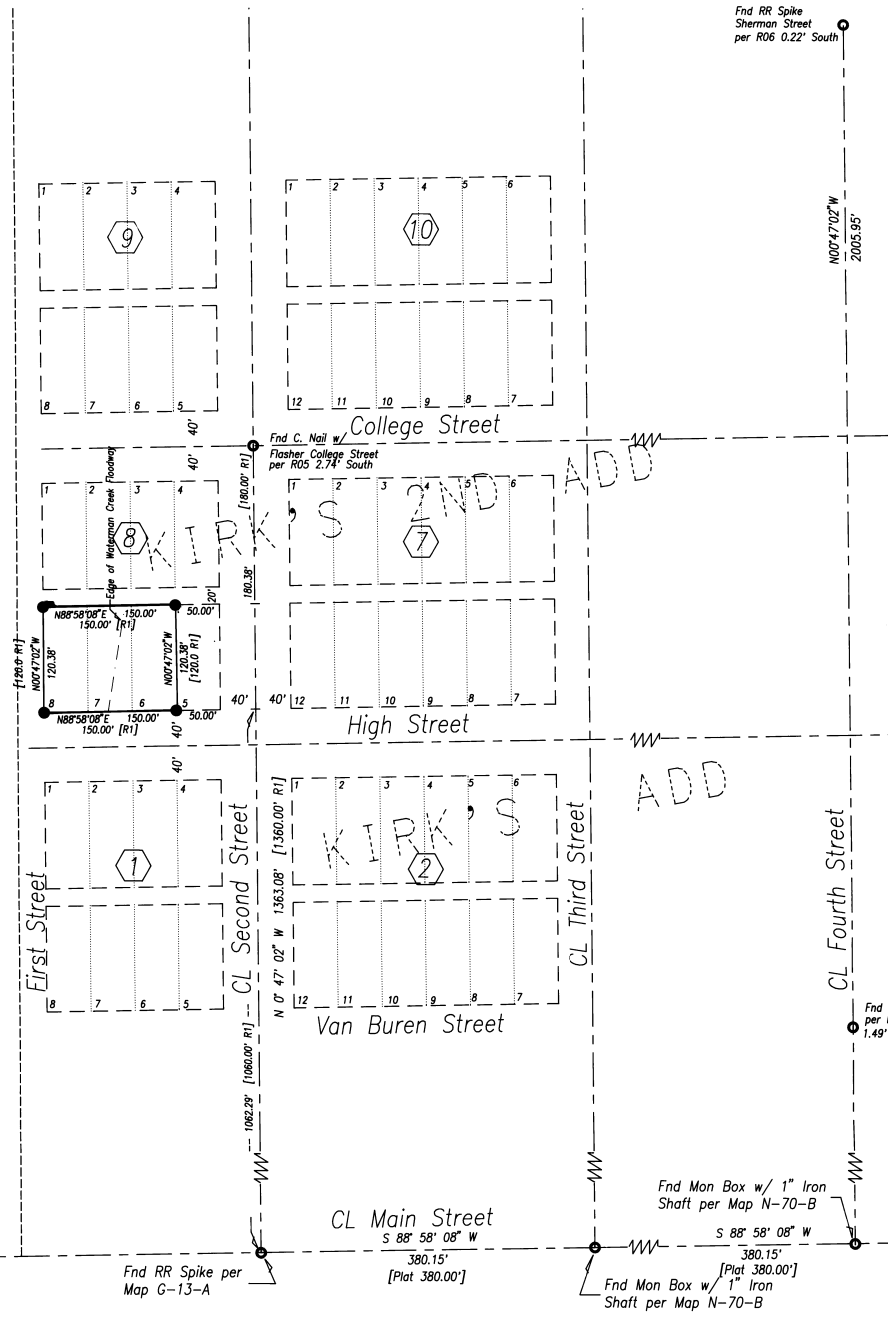

Description
 Lots 6, 7, and 8 of Block 8 of Kirk's 2nd Addition to the Town of Centerville, now City of Athena.

Reference Documents
 R01 Deed Book 'H' at page 425, Records of Umatilla County
 R02 Map N-70-B, Records of the Umatilla County Surveyor
 R03 Map G-13-A, Records of the Umatilla County Surveyor
 R04 Map 87-21-A, Records of the Umatilla County Surveyor
 R05 Map P-125-A, Records of the Umatilla County Surveyor
 R06 Map 90-11-A, Records of the Umatilla County Surveyor
 R07 FLOODWAY Flood Boundary and Floodway Map - City of Athena, Oregon, Umatilla County - FEMA July 16, 1984

Narrative of Survey
 A survey to monument the described property. Survey commenced on October 14, 1996.
 Instrument used was a Topcon GTS2-06. Four angles were observed by repetition for the traverse.
 Bearings are Grid, Oregon Coordinate System of 1983, North Zone, and are based on observations from Athena NGS, theta < +1' 26" 23".
 As was noted Map 90-011-A, and subsequent surveys, the distance from Main Street to the North line of Section 19 is 3.72 feet longer than the platted dimensions, which are vague.
 The method used to calculate these dimensions was: to set North-South streets parallel to monumented Fourth Street; to set East-West Streets parallel to Main Street; using the dimensions of Railroad Addition, to set the North Lines of Railroad Addition to the currently accepted positions of section corners to the East and West; and to evenly proportion the excess distance between Main Street and Washington Street.
 Monuments of record were found as noted.

REGISTERED PROFESSIONAL LAND SURVEYOR
Dwight M. Bartleson
 OREGON
 JULY 26, 1985
 DWIGHT M. BARTLESON
 02166LS
 Renews: Dec. 31, 1997

SE4 of NW4 Section 19, T4N, R35E, WM, Umatilla County, Oregon

A Record of Survey for
Kevin James
 P.O. Box 682
 Athena, Oregon 97813
 4-97
 KK
 97-57-B

Dwight M. Bartleson L.S.
 79902 LaMar Gulch Road
 Athena, Oregon 97813
 (541) 566 - 2397

Drawn By: DMB	Date: April 14, 1997	Sheet 1 of 1
---------------	----------------------	--------------