
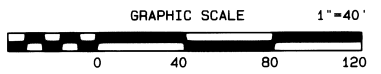


BASIS OF BEARINGS
 CENTERLINE OF DORION AVENUE FROM CITY SURVEY

RECORD DIMENSIONS FOR LOT 1 AS SHOWN ON THE RESERVATION ADDITION PLAT.

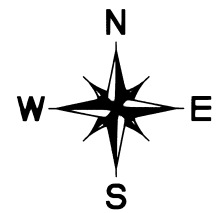

NARRATIVE OF SURVEY

This survey was performed at the request of Mr. Rigoberto Amaral. The purpose of the survey was to identify the boundaries of the lots as shown in preparation for building a fence along the southeasterly line of the property. The boundaries were established from the found monumentation set by the City of Pendleton. The deed of record used is recorded in Reel 340 at Page 0014 of the Umatilla County Deed Records. The legal description is a metes and bounds description to account for the portion of the property which lies in Arnold's and Raley's addition. The dimensions of Lot 1 were calculated by single proportionate methods without the area which lies in Arnold's and Raley's Addition. The difference in the Lot dimensions obtained by including that area was 0.003' which has no effect on the end result. The control for the survey was established using a LEICA SYSTEM 300 RTK GPS and the monuments were set using a GEODIMETER system 600 electronic total station and radial methods.

SECTION 10, T2N, R32E, W.M.
 SE1/4 OF THE NE1/4
 UMATILLA COUNTY, OREGON
 LOTS 1 AND 2, BLOCK 57
 RESERVATION ADDITION
 TO THE CITY OF PENDLETON

LEGEND

- FOUND BRASS CAP BY THE CITY OF PENDLETON
- FOUND PK NAIL BY THE CITY OF PENDLETON
- SET LEAD PLUG IN A DRILL HOLE IN THE SIDEWALK WITH A 1 1/8" BRASS WASHER STAMPED ORLS 852 AND WALS 13922
- SET A 5/8" x 24" IRON REBAR WITH A RED PLASTIC CAP STAMPED ORLS 852 AND WALS 13922
- × COMPUTED POINT
- R1 ARNOLD & RALEY'S ADDITION, DEED BOOK C, PAGE 319
- R2 RESERVATION ADDITION PLAT BOOK 1, PAGE 83
- R3 CITY MAP 24-7742 COUNTY SURVEY No. 89-127-B

RECEIVED BY
 Umatilla County Surveyor
 9-99
 99-154-B

REGISTERED PROFESSIONAL LAND SURVEYOR
 David L. Haddock
 OREGON
 JULY 12, 1988
 DAVID L. HADDOCK
 RENEWS 6-30-08

PROJECT No. 99-21
 SURVEY FOR
 Mr. Rigoberto Amaral
 814 S.W. 15th St.
 Pendleton, Or. 97801

MONUMENTS SET: August 2nd, 1999
 David L. Haddock, Surveyor and Engineer
 P.O. Box 1574
 Pendleton, Oregon 97801
 (541) 276-2174
 HADDOCK SURVEYING
 GPS AND TOTAL STATION