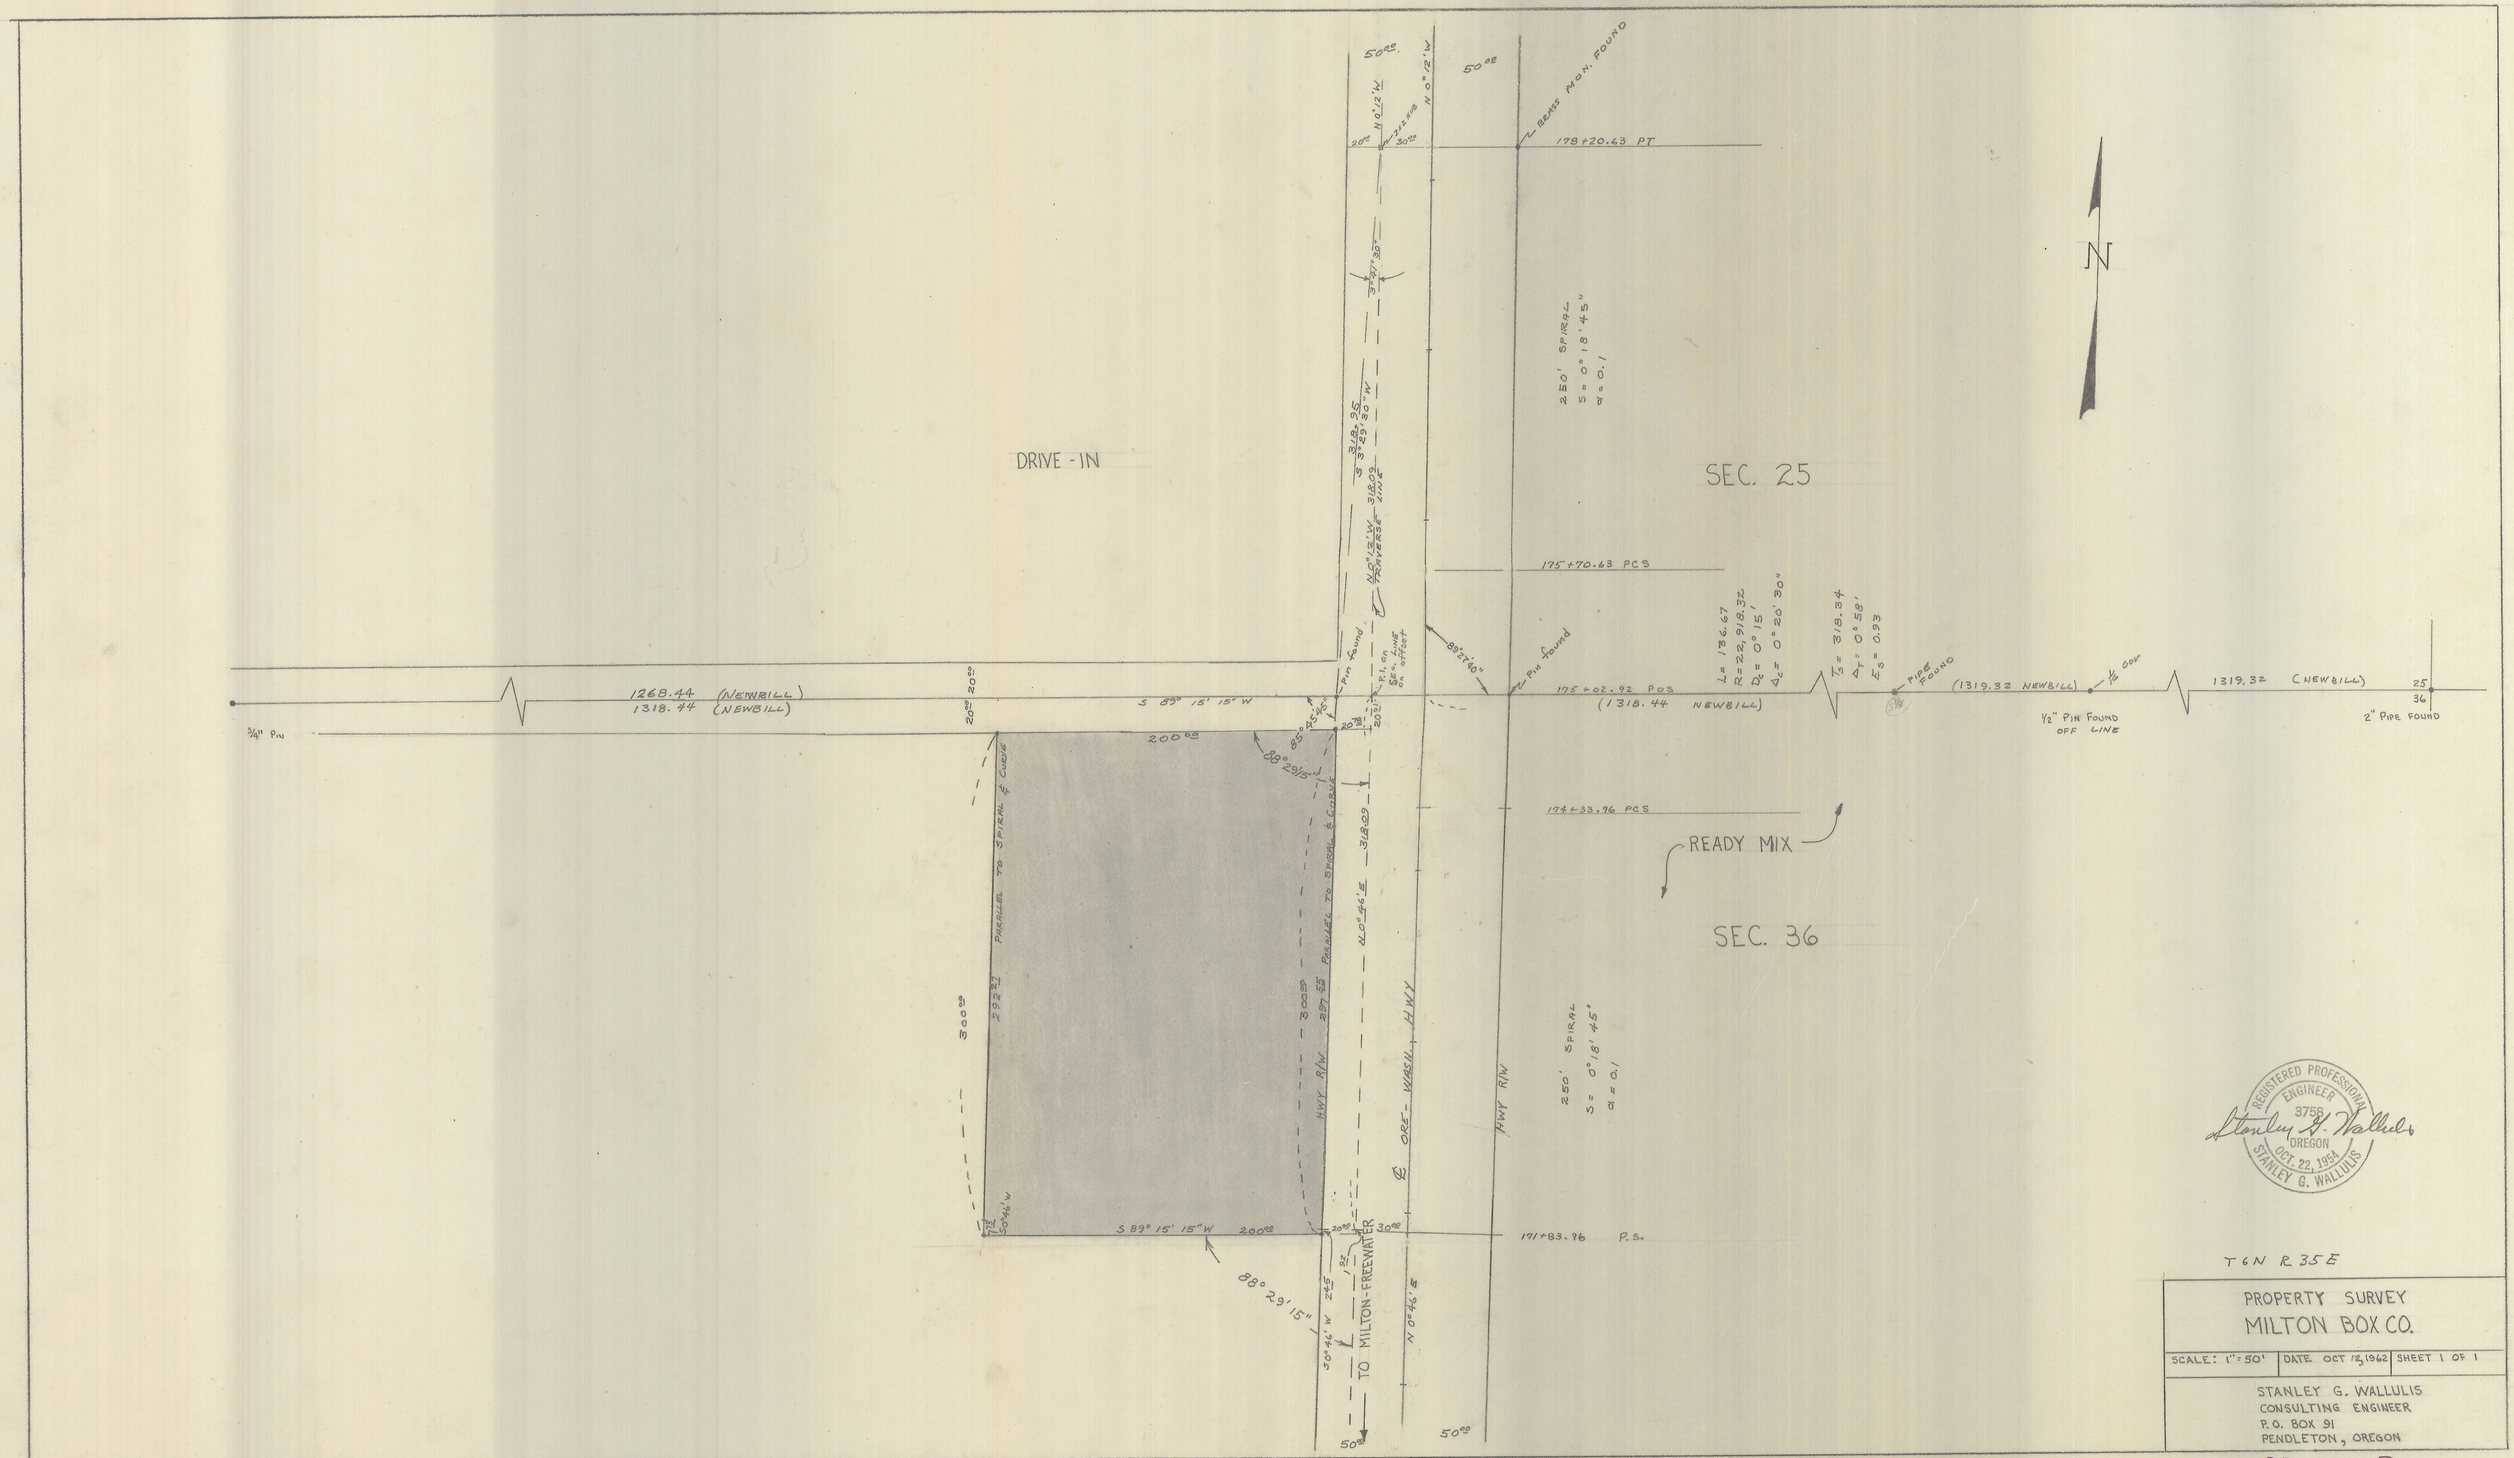

REGISTERED PROFESSIONAL ENGINEER 3758 OREGON OCT. 22, 1954 STANLEY G. WALLULIS

Stanley G. Wallulis

PROPERTY SURVEY
MILTON BOX CO.

SCALE: 1" = 50'	DATE OCT 12, 1962	SHEET 1 OF 1

STANLEY G. WALLULIS
CONSULTING ENGINEER
P.O. BOX 91
PENDLETON, OREGON

99-226-B