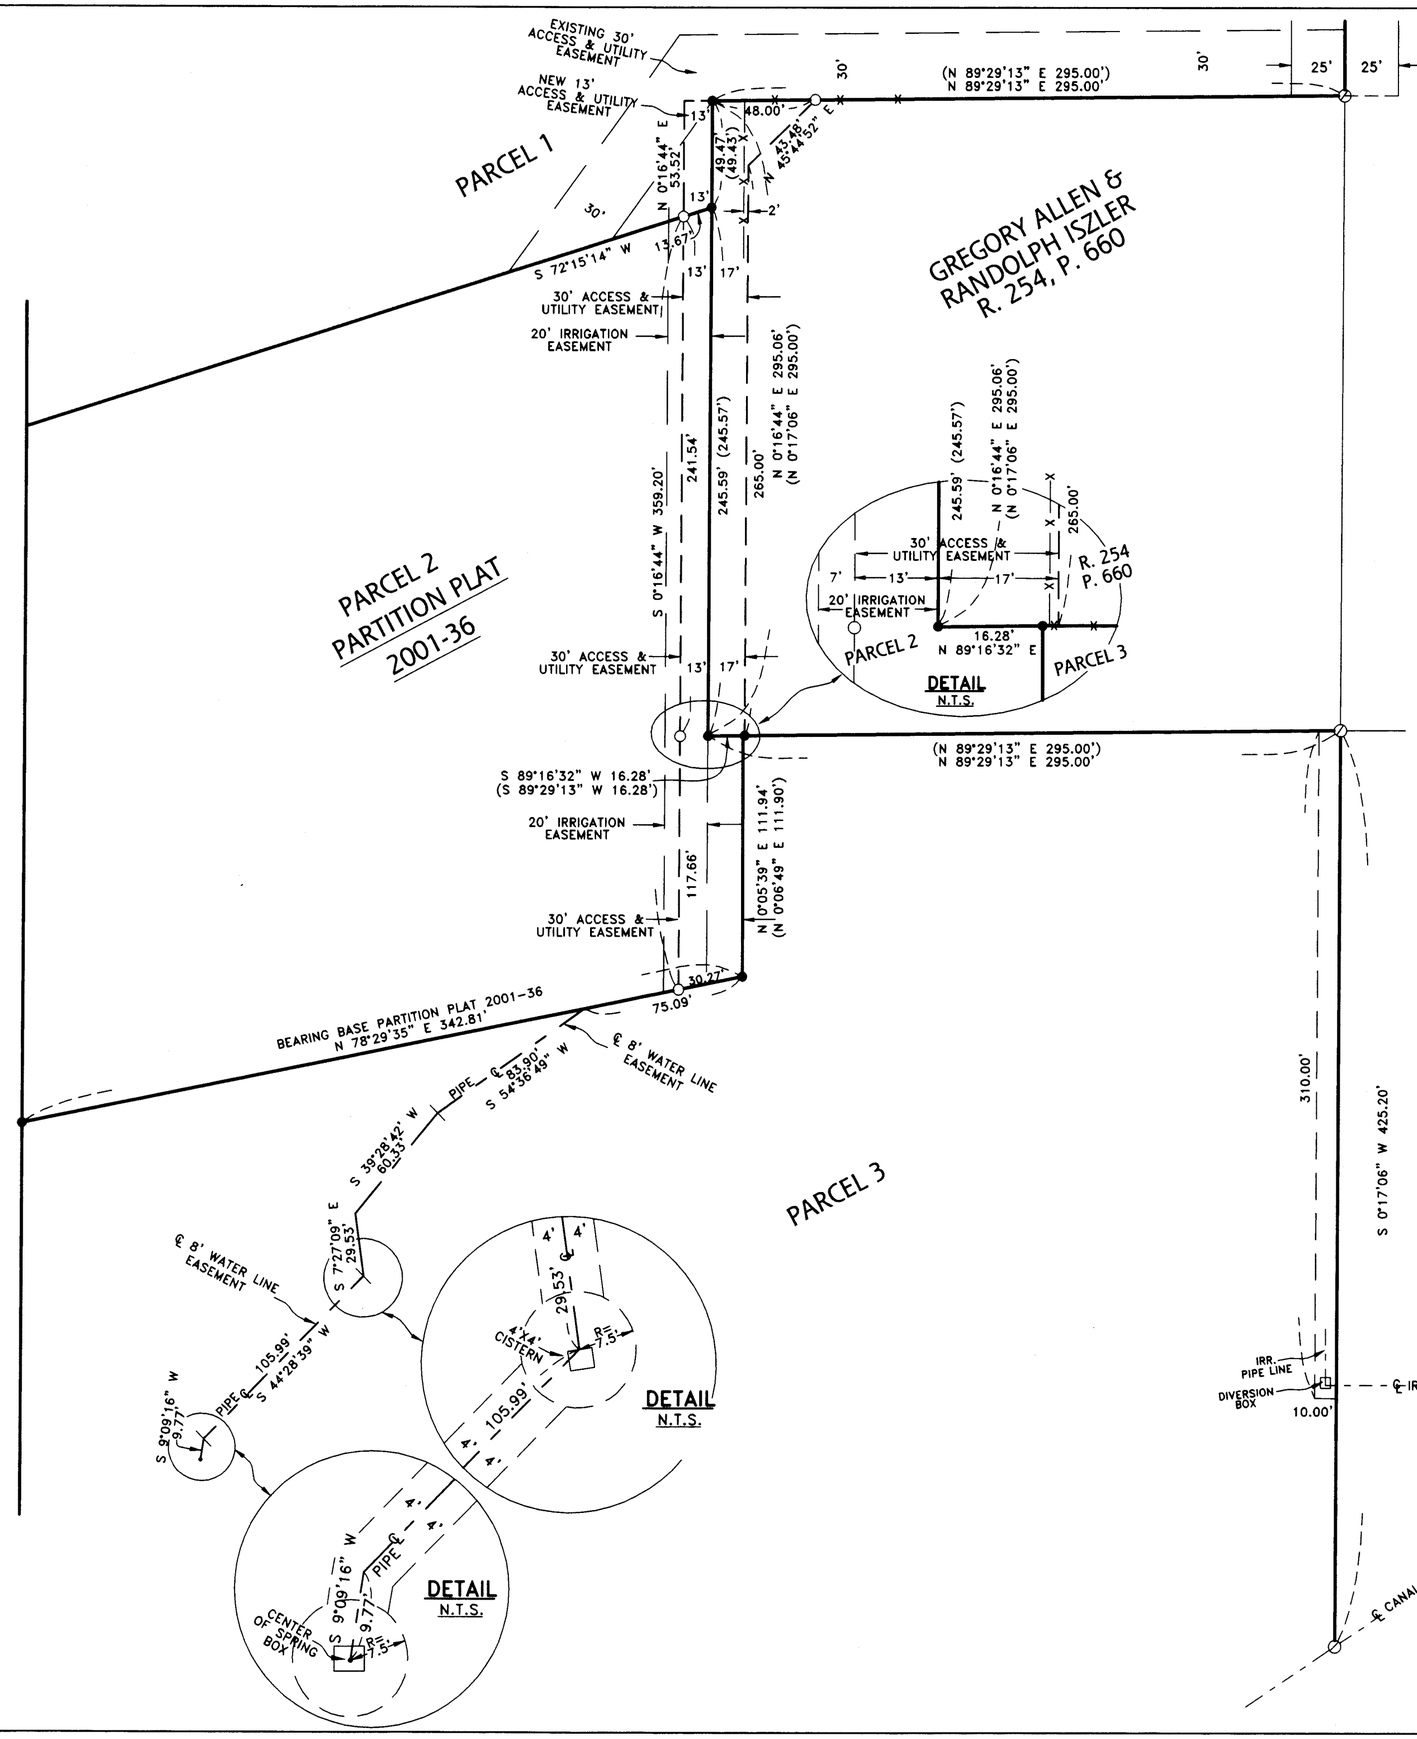

NARRATIVE:

THE PURPOSE OF THIS SURVEY IS TO SURVEY A WATER LINE AND AN ACCESS EASEMENT AND AN IRRIGATION EASEMENT AND TO DESCRIBE THEM.

I BASED THE BEARINGS OF ROBERTS' PARTITION PLAT 2001-36.

REGISTERED PROFESSIONAL LAND SURVEYOR

G. Dennis Edwards

OREGON
JULY 16, 1971
G. DENNIS EDWARDS
9 5 1
RENEWS 12/31/2005

LEGEND:

- ● FOUND 5/8" IRON REBAR, ROBERTS P. PLAT 2001-36
- ○ SET 5/8"X30" IRON REBAR WITH PLASTIC CAP #951
- ⊘ COMPUTED LOCATION

SURVEY FOR RICHARD AYERS
IN NW 1/4, SEC. 7, T 4 N, R 29 E, W.M., W.M., UMATILLA COUNTY, OREGON
10/2/2004 JOB# S0410210
EDWARDS SURVEYING P.O. BOX 763
541-567-3336 HERMISTON, OREGON 97838
DRAWN BY NJF

RECEIVED BY
Umatilla County Surveyor
Date 2-05
Rec'd By KK

05-040-B