
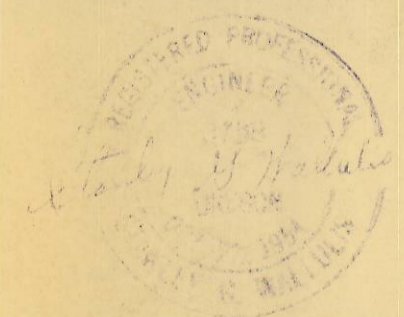


YOUNGS ADDITION TO CITY OF PENDLETON, OREGON
 SW OLSON AVENUE

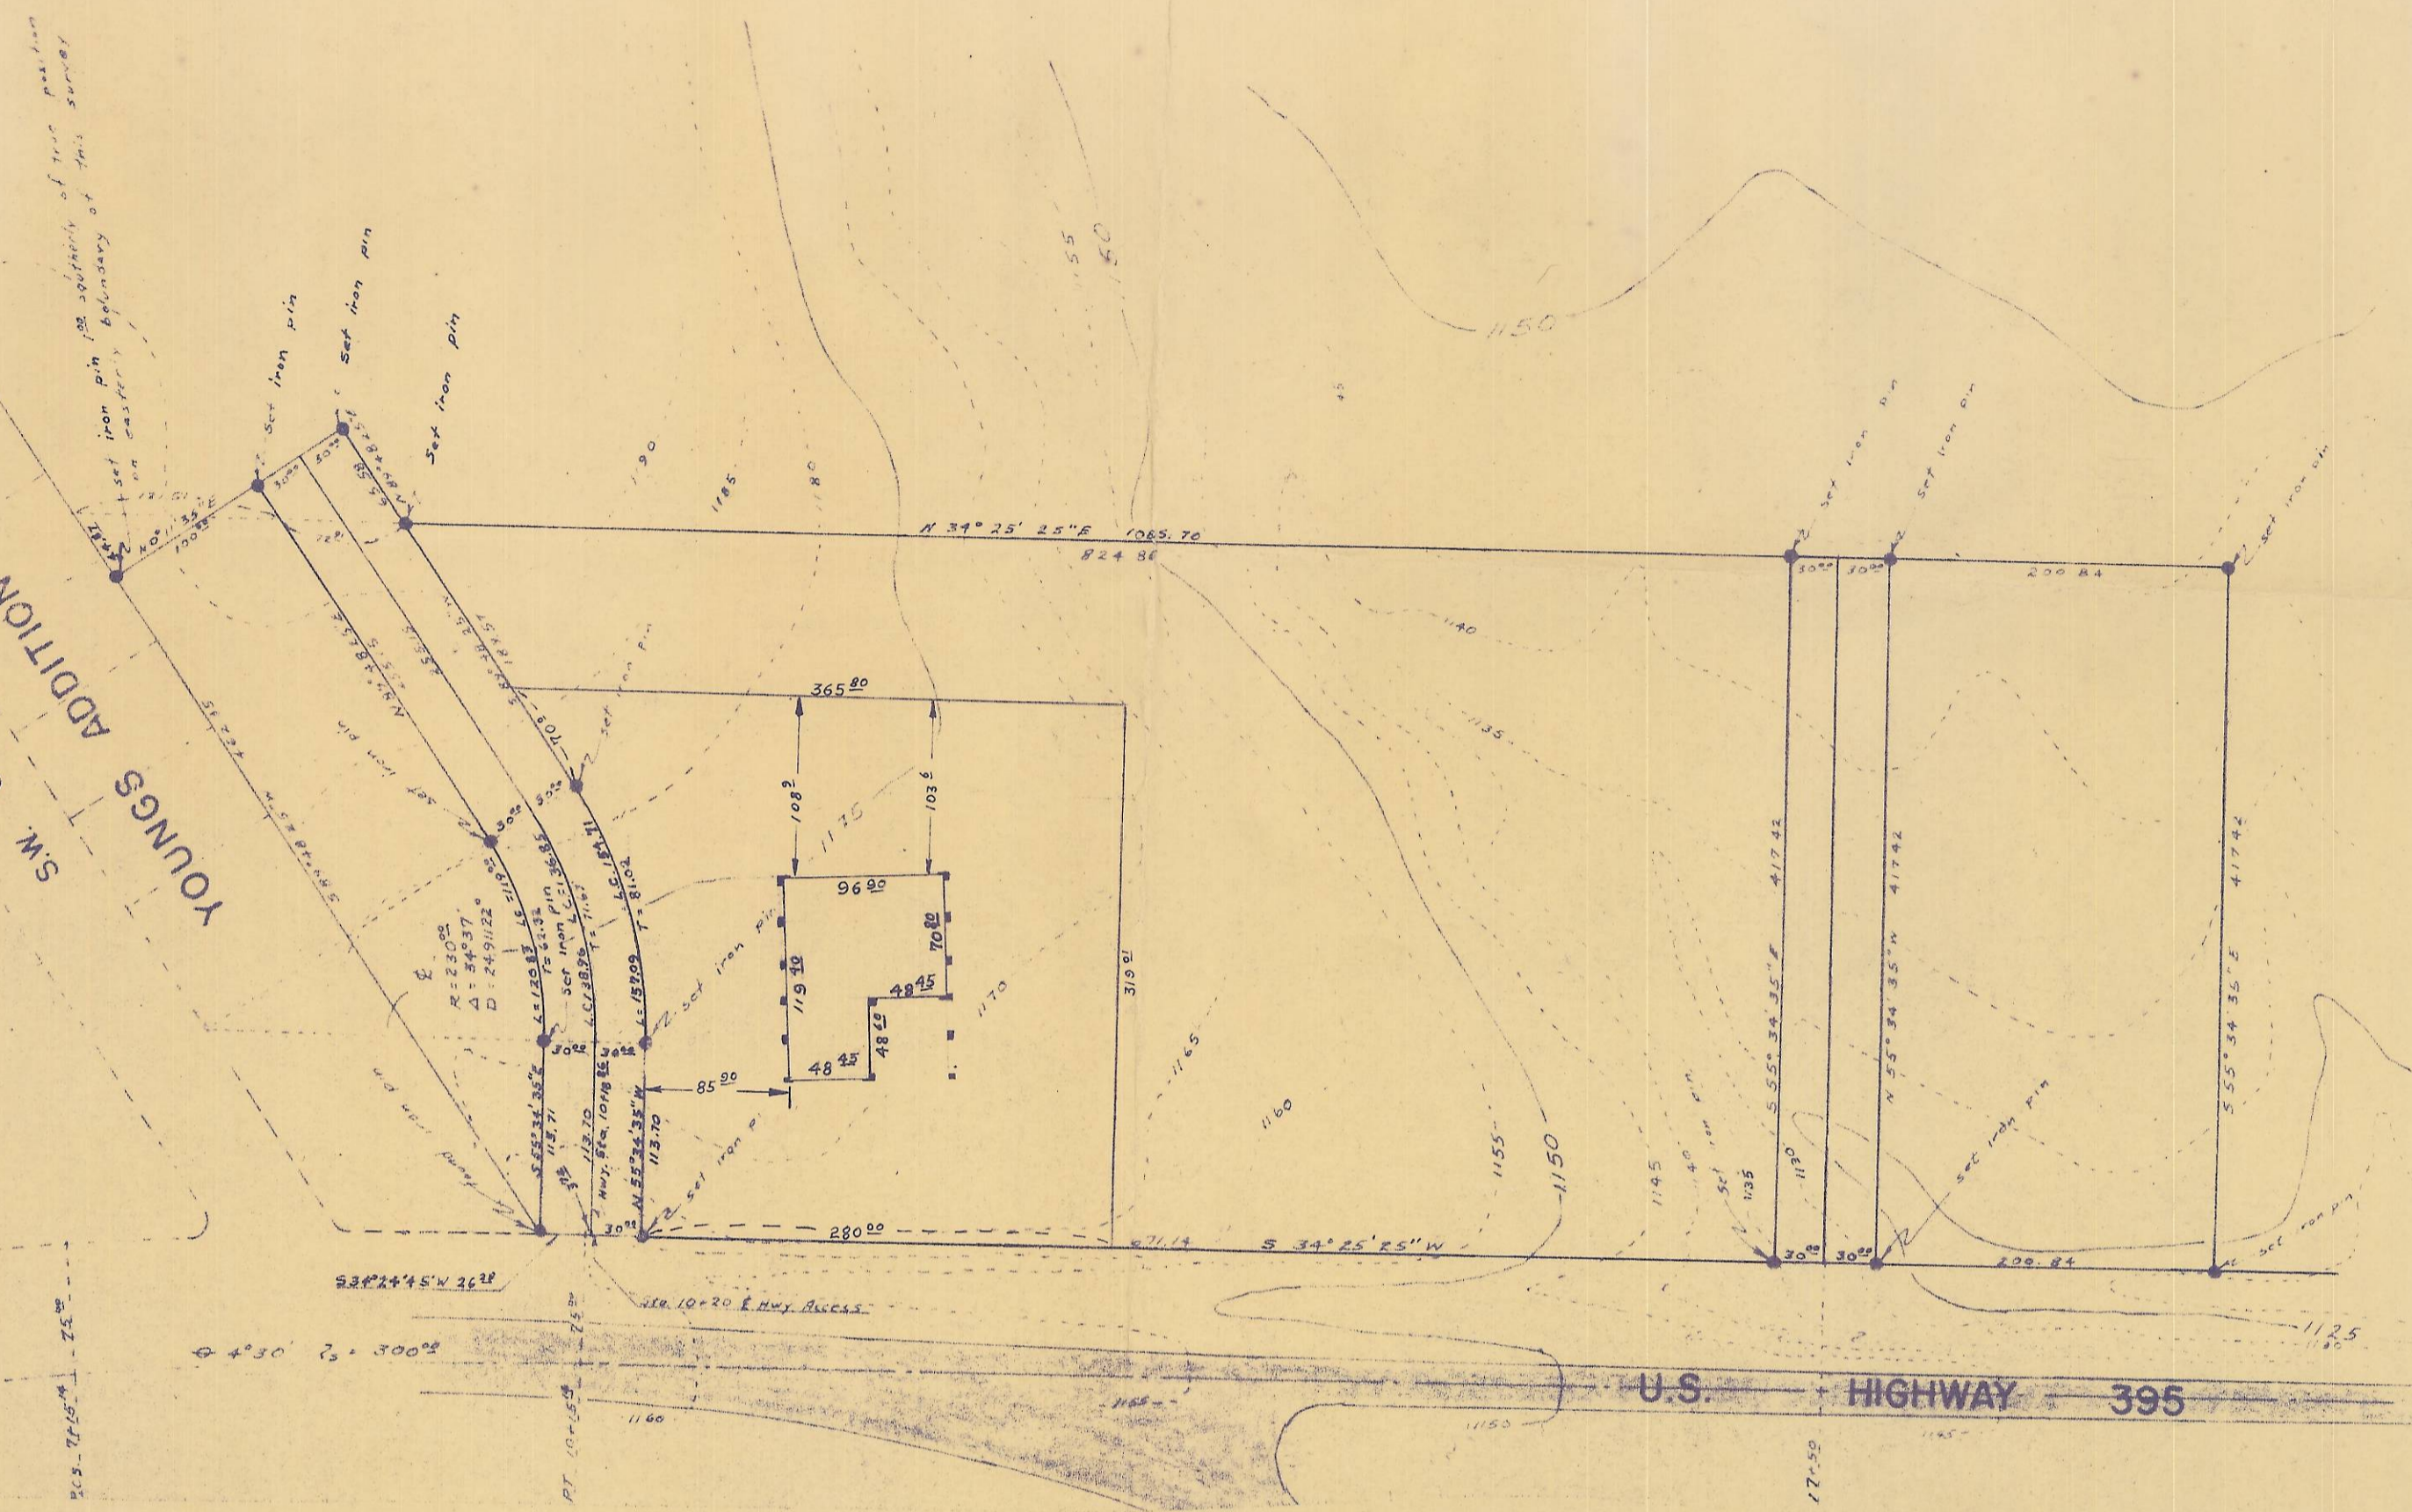

Survey For
MEL WINTER
 Drawn by: S.G.W. Date: 6-28-66 Scale: 1" = 100'
WALLULIS & STAEBLER
 Consulting Engineers
 P.O. Box 91
 Pendleton Oregon

2N32 16
 DA 08-020-B